MW

ICHD - ENVIRONMENTAL HEALTH DIVISION

Statesville Office (704) 878-5305 Mooresville Office (704) 660-3625 PERMIT # AP 2022-7072

SEPTIC: IMPROVEMENT PERMIT / AUTHORIZATION TO CONSTRUCT / OPERATION PERMIT / EXISTING SYSTEM

PIN # 4701 -- 68 -- 8240

APPLICANT/OWNER: Allen Edwards APPLICANT ADDRESS: 149 Lady Slipper Dr, Statesville

SITE ADDRESS: 149 Lady Slipper Dr, Statesville 28625 PHONE: 704-880-6997 ALT. PHONE


SITE DIRECTIONS: Old Mountain - E Lewis Ferry - W Lewis Ferry - Canal - Lady Slipper SAP CONTROLLED: ☐ YES ☒ NO

SUBDIVISION: - SECTION: - LOT # - LOT AREA: 0.91 acres DESIGN FLOW: 360 gpd L.T.A.R.: 0.3

Septic Tank	1000 (gal)	STB 760	Date 10/17/22	☐ New System ☒ Repair ☐ Expansion	System Type: I II (III) IV V VI	☒ Residence	No. Bedrooms 3	Water Supply
Pump Tank	(gal)	PT	Date	System Description:		☐ Business	No. Persons 6	☐ Private
Pump Make		Model	Serial #	Repair System Description: 25% reduction		☐ Other	No. Employees	☐ Public
# Nitrification Fields	1	# Lines 3	Linear Ft 300'	Maintenance Agreement Required:	☐ YES ☒ NO	☐ Slab	☐ Crawl Space	☐ Community
Trench Width	36"	Trench Bottom Depth ~~(Low side)~~	36" Max	Gravel Depth -	☒ GRAVITY ☐ PRESSURE	☐ Basement w/ plumbing		☐ Basement w/o plumbing

Comments / Conditions: Keep 50' from existing well. Pump, crush, & fill old septic tank. Install lines on contour with the land. Do not grade, drive, or park on septic area.

INITIAL SITE SKETCH

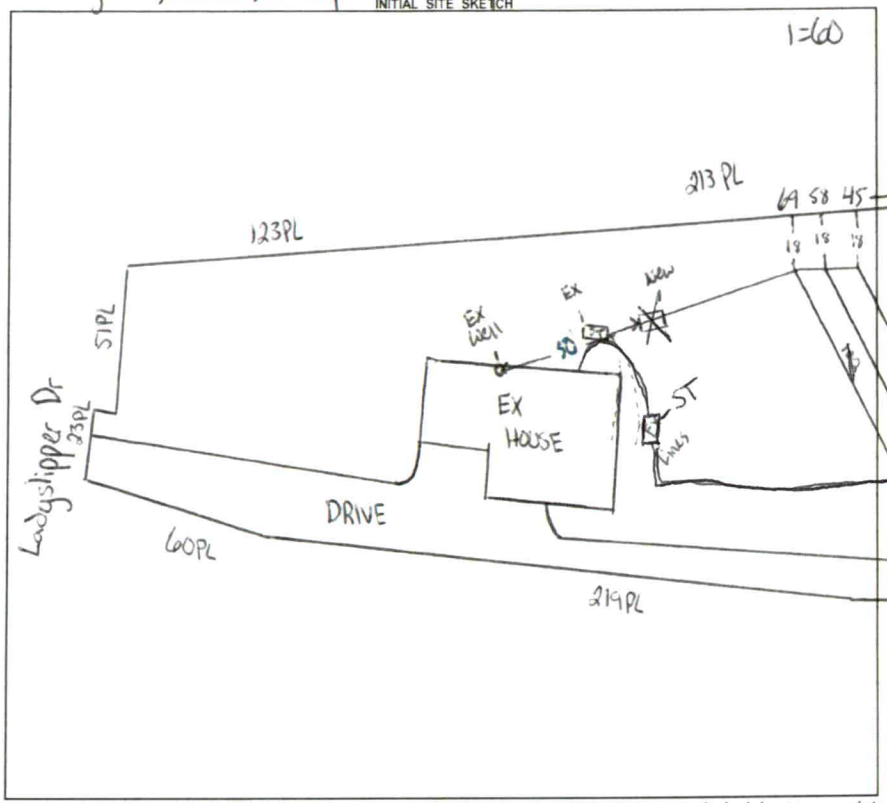

AS BUILT SKETCH

FOR SEPTIC FINAL INSPECTION CALL: 704-664-3703 between 8am-9am the day the inspection is needed. Be sure to speak with an inspector to confirm your time.

Installed as Drawn

Permit can be suspended or revoked if any false information is supplied toward securing the permit / any unauthorized changes are made to the site / any unauthorized changes are made in the installation of the system. **CONTACT A LOCATOR SERVICE PRIOR TO ANY EXCAVATION**

☐ **IMPROVEMENT PERMIT** ***with plat*** *valid without expiration.* ☒ **IMPROVEMENT PERMIT** ***with site plan*** *valid for 60 mos.* ☒ **AUTHORIZATION TO CONSTRUCT** *valid for period equal to IMPROVEMENT PERMIT--not to exceed 60 mo.*

Owner / Applicant Signature: Online Signature Date: Installed by: Lentz Wastewater

IMPROVEMENT PERMIT by: Cory Hill Date: 11/2/22 OPERATION PERMIT by: Cory Hill Date: 11/23/22

AUTHORIZATION TO CONSTRUCT by: Cory Hill Date: 11/2/22 Existing System Inspected by: Date:

FOR SEPTIC FINAL INSPECTION: CALL 704-664-3703 between 8am-9am the day the inspection is needed.