48736

IREDELL COUNTY HEALTH DEPARTMENT

STATESVILLE 704-878-5305 MOORESVILLE 704-664-5281

IMPROVEMENT PERMIT / CERTIFICATE OF COMPLETION / OPERATION PERMIT / EXISTING SYSTEM INSPECTION

PROPERTY DESCRIPTION NO. 16946 DATE 9-15-93 TAX MAP NO. 3H-A-3 (3N-A-3) on Computer

OWNER OR CONTRACTOR Bobby Pope PHONE: Business Home 528-9753

ADDRESS Rt. 3 Box 240 E Statesville, N.C. 28677

LOCATION I40 W TL old Mtn. Rd. TR Lewis Ferry Rd. Lot at end of W. Lewis Ferry Rd.

SUBDIVISION NA BLOCK / SECTION LOT 1 LOT AREA .796 SITE CLASS. P.S. L.T.A.R. .35 gpd/ft²

Water Supply: ☑ Individual ☐ Community ☐ Public Share well with house next door

Septic Tank: 1000 Gallons; STB 358 Date —

Pump Tank: — Gallons; PT — Date —

Nitrification Field: No Fields 1 Square Feet 690 Linear Feet 230'

No Lines 3 Trench Width 36" Trench Depth 18'-36" Gravel Depth 12"

☑ New System ☐ Repair System Type: I (II) III IV V VI

System Description: Conventional, gravity

Repair System Description: Pump to conventional

Maintenance Agreement Required: ☐ Yes ☒ No

☑ House/Mod. Home ☐ Mobile Home ☐ Business ☑ Other Garage Apt.

No. Bedrooms 2 No. Bathrooms 1 No. Employees —

Garbage Disposal: ☐ Yes ☑ No

Auto. Dishwasher: ☑ Yes ☐ No


Auto. Washing Machine: ☑ Yes ☐ No

Other —

☑ Slab ☐ Crawl Space ☐ Basement w/plumbing ☐ Basement wo/plumbing

Comments Install system as shallow as possible. Keep lines on contour. Keep system min. 5' from foundation of home, 10' from all property lines, and min. 50' from any well. 100% Repair area above system, pump to conventional.

INITIAL SITE SKETCH

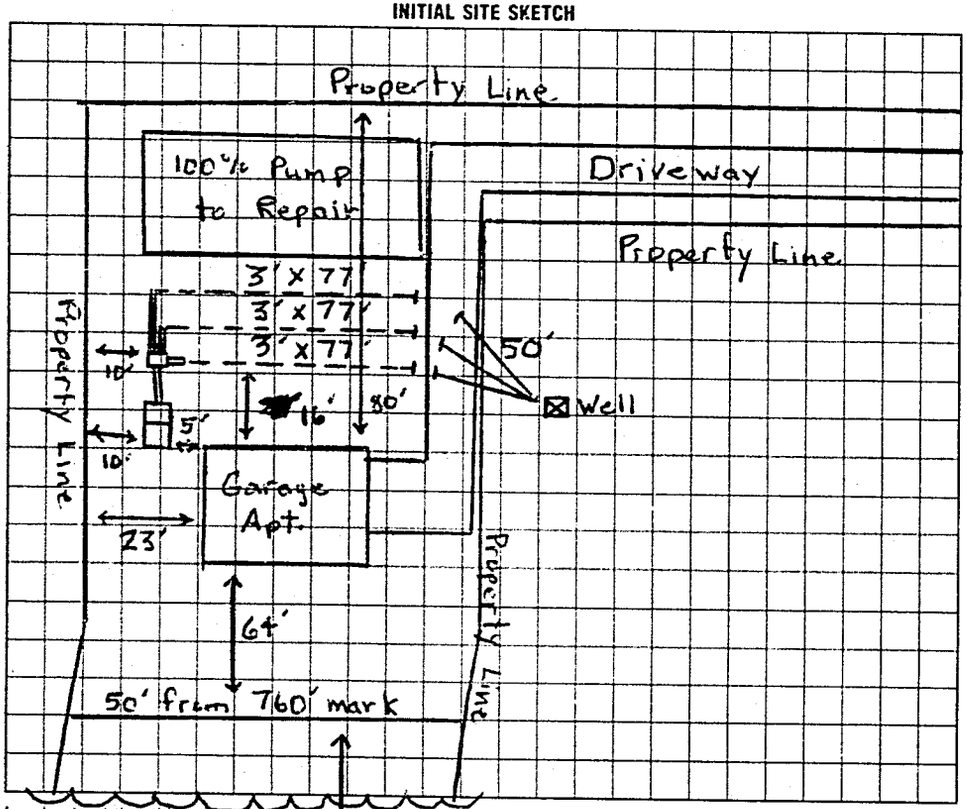

AS BUILT SKETCH

* Home moved from orginal location (up slope from level area)
- Area around home cut down, caused drain line to be installed deeper than what was permitted

SAME AS INITIAL SKETCH

I understand that this permit can be suspended or revoked if any false information is supplied toward securing the permit/any unauthorized changes are made to the site/any unauthorized changes are made in the installation of the system. Improvement Permit is valid for 60 months from date of issuance.

Signed: Bobby D Pope

Improvement Permit by: Michael J. Dennis date 9-15-93

Existing System Inspection by: — date —

Installed by: A-1 Backhoe

Certificate of Completion by: Michael J. Dennis date 3-25-94

Operation Permit by: — date —

HEALTH DEPT COPY WHITE INSPECTION COPY (FINAL) GREEN OWNER COPY (FINAL) YELLOW INSPECTION COPY (INITIAL) PINK OWNER COPY (INITIAL) GOLD

S 6 L 0 0