Not on Comp

IREDELL COUNTY HEALTH DEPARTMENT

STATESVILLE 704-878-5305 MOORESVILLE 704-664-5281

IMPROVEMENT PERMIT / CERTIFICATE OF COMPLETION / OPERATION PERMIT / EXISTING SYSTEM INSPECTION

PROPERTY DESCRIPTION NO. 19610- [illegible] DATE 3-21-95 TAX MAP NO. 3N-A-12 Watershed: ☐ Yes ☑ No

OWNER OR CONTRACTOR Brian D. Sougnez PHONE: Business Home 528-9479

ADDRESS 461 Carriage Rd. Statesville N.C. 28677

LOCATION I40W TL Old Mtn. Rd TR Celeste-Eufola Rd TL Eufola Rd TR Carriage Rd Lot at end on L

SUBDIVISION NA BLOCK / SECTION — LOT — LOT AREA 34,807 sq. ft SITE CLASS. P.S. DESIGN FLOW 480 L.T.A.R. 4 gpd/ft²

Septic Tank: 1000 Gallons; STB 1012 Date 7-19-97

Pump Tank: — Gallons; PT — Date —

Pump Make: — Model — Serial No. —

Nitrification Field: No Fields 1 Square Feet 1200 Linear Feet 400'

No Lines 3 Trench Width 36" Max Trench Bottom Depth 30"

☑ New System ☐ Repair System Type: I, II, III, IV, V, VI

System Description: conventional, gravity fed.

Repair System Description: Pump to conventional

Maintenance Agreement Required: ☐ Yes ☑ No

Gravel Depth 12" ☐ Slab ☐ Crawl Space ☑ Basement w/plumbing ☐ Basement wo/plumbing

☑ House/Mod. Home No. Bedrooms 4

☐ Mobile Home No. Bathrooms 3


☐ Business No. Employees —

☐ Other —

Water Supply: ☑ Individual ☐ Community ☐ Public Share well with Neighbor

Comments: Install system shallow (no deeper than 30") to bottom of trench on upper side of trench. Keep lines and trenches on contour. Keep system 50' from 760' elevation mark, max. Feasable distance from any well and no closer than 50', 5' from

INITIAL SITE SKETCH foundation of home, and 10' from property lines.

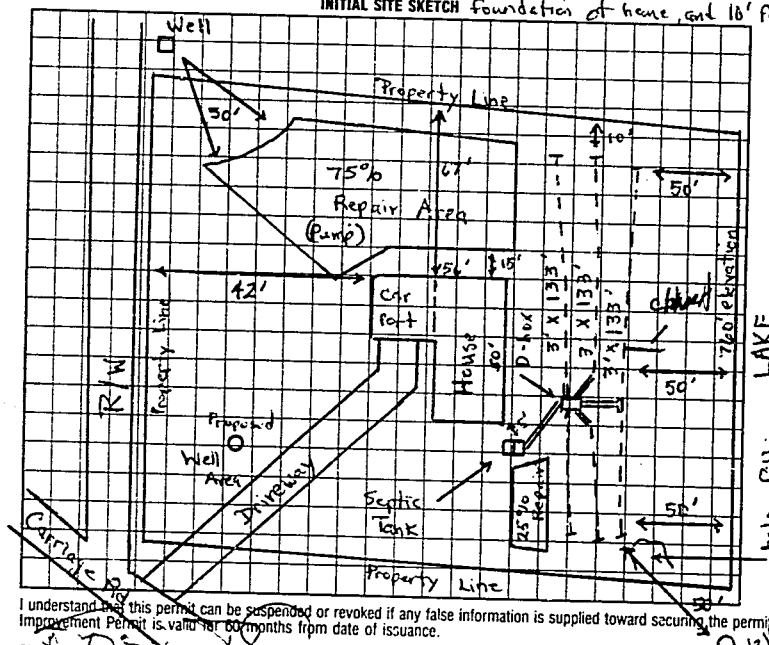

Comments:

* Found closed at last line — will break & remove, dirt will be Packed Back into pipes

AS BUILT SKETCH

100% Repair above system pump to conventional (75% pump, 25% gravity).

Fill in hole to natural grade, Keep 5' from hole

* Lines each split feed with Bores
* Make Sure Basement Drain - solid pipe over system.
* Installed as shown

I understand that this permit can be suspended or revoked if any false information is supplied toward securing the permit/any unauthorized changes are made to the site/any unauthorized changes are made in the installation of the system. Improvement Permit is valid for 60 months from date of issuance.

Signed: Brian D. Sougnez

Improvement Permit by: Michael G. Dennis date 3-21-95

Existing System Inspection by: — date —

Installed by: Tommy Frye

Certificate of Completion by: — date —

Operation Permit by: Mark C Ortiz date 10-1-97

HEALTH DEPT. COPY: WHITE INSPECTION COPY (FINAL): GREEN OWNER COPY (FINAL): YELLOW INSPECTION COPY (INITIAL): PINK OWNER COPY (INITIAL): GOLD