483-1690 DAR

IREDELL COUNTY HEALTH DEPARTMENT

STATESVILLE 704-878-5305 MOORESVILLE 704-664-5281

PROVEMENT PERMIT / AUTHORIZATION TO CONSTRUCT / OPERATION PERMIT / EXISTING SYSTEM INSPECTION

PERMIT# 10944 PIN# 4701-87-7566 DATE 3-29-03

OWNER OR CONTRACTOR W. E. WILLIAMS PHONE: Business Home 704-489-8062

ADDRESS 432 CARRIAGE ROAD, STATESVILLE NC 28677

LOCATION US 70 WEST, TL EMFOLA ROAD, TR CARRIAGE ROAD, 5TH BEFORE END ON RIGHT

SUBDIVISION BLOCK / SECTION LOT LOT AREA 0.94 ACRES SITE CLASS. PS DESIGN FLOW 360 L.T.A.R. 0.25 GPD/FT²

Septic Tank: 1000 Gallons; STB 794 Date 03/03/03
Pump Tank: Gallons; PT Date
Pump Make: Model Serial No.
Nitrification Field: No Fields 1 Square Feet EQ TO 1440 Linear Feet 240
No Lines EIGHT Trench Width 24" Max Trench Bottom Depth 36" ~~Gravel~~ Depth SAND 6"

☑ New System ☐ Repair System Type: I, II, (III), IV, V, VI
System Description: 50% REDUCTION GRAVITY
Repair System Description: MAXIMUM FEASIBLE AREA (.1945)
Maintenance Agreement Required: ☐ Yes ☑ No

☑ House/Mod. Home No. Bedrooms 3
☐ Mobile Home No. Bathrooms 2
☐ Business No. Employees
☐ Other
☐ Slab ☐ Crawl Space ☑ Basement w/plumbing ☐ Basement wo/plumbing


Water Supply: ☑ Individual ☐ Public ☐ Community
WELL

Comments/Conditions: ① CONSTRUCT SUBSURFACE INTERCEPT DRAINAGE DITCH AT LOCATION SHOWN BEGINNING 48" DEEP — AROUND SYSTEM - THEN OUT TO DAYLIGHT ③ INSTALL 50% REDUCTION SYSTEM USING FIFTY-SIX (56) PANELS


Comments/Conditions: Checked top left line - okay 4/29/03 - LM
& tank.

SEPTIC TANK IS 20' TO NEIGHBORS WELL, NO SAPROLITE ON SIDE STREET SO IT'S ALLOWED, LC

INITIAL SITE SKETCH

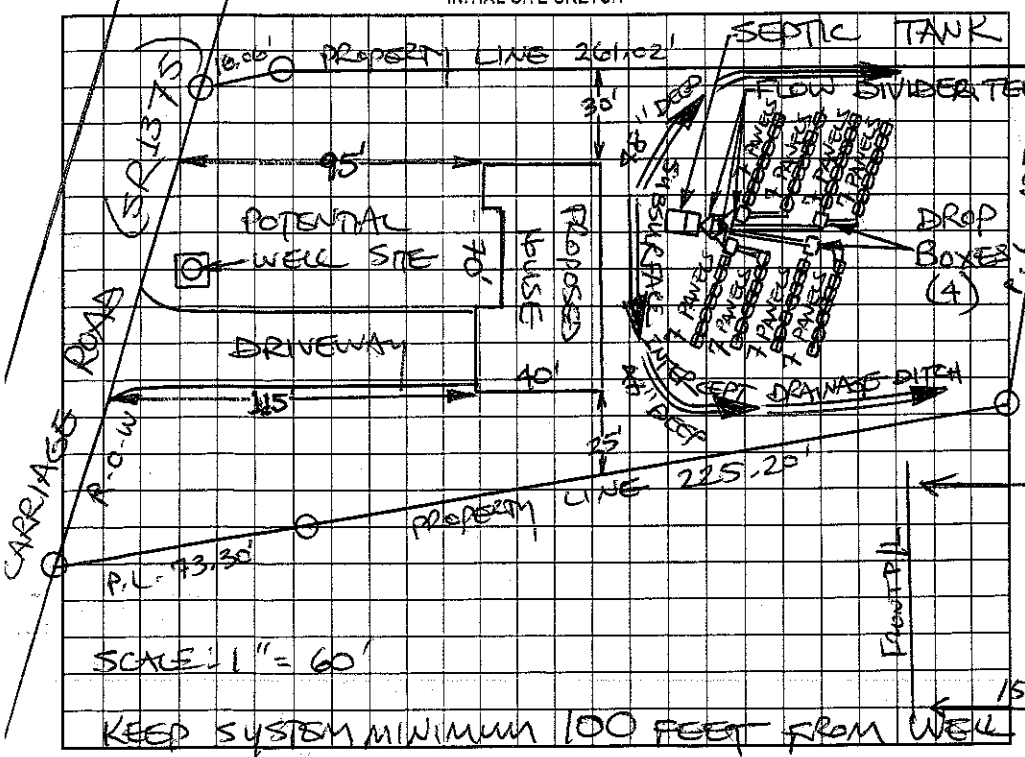

AS BUILT SKETCH

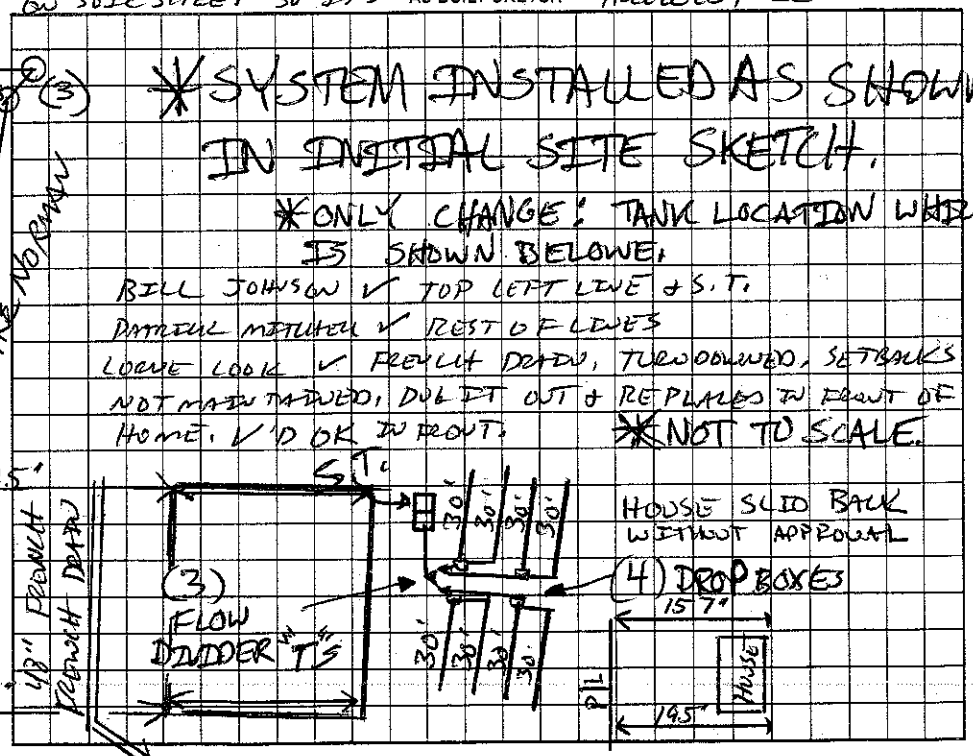

Permit can be suspended or revoked if any false information is supplied toward securing the permit/any unauthorized changes are made to the site/any unauthorized changes are made in the installation of the system. Improvement Permit with plat valid without expiration. Improvement Permit with site plan valid for sixty months. Authorization to Construct is valid for a period equal to that of Improvement Permit – not to exceed sixty months.

Signed: W. E. Williams date 4-09-03 Installed by: DAVID CLARK

Improvement Permit by: STEVE HEDRICK date 3-29-03 Operation Permit by: [signature] PS date 3-11-04

Authorization to Construct by: STEVE HEDRICK date 3-29-03 Existing System Inspection by: date

HEALTH DEPT. COPY: WHITE OWNER COPY (FINAL): YELLOW OWNER COPY (INITIAL): PINK