John Swaim 459 Carriage Rd Statesville NC

201669

IREDELL COUNTY HEALTH DEPARTMENT

STATESVILLE 704-878-5305 MOORESVILLE 704-664-5281

IMPROVEMENT PERMIT / CERTIFICATE OF COMPLETION / OPERATION PERMIT / EXISTING SYSTEM INSPECTION

PROPERTY DESCRIPTION NO. 23246 DATE 3-18-96 TAX MAP NO 3N-A-20 Watershed: IN WA / No

OWNER OR CONTRACTOR JOHN SWAIM PHONE: Business (910) 744-7404 Home

ADDRESS RT. 4, BOX 396, EAST BEND, NC 27018

LOCATION BUFFALO SHOALS RD, TR EUFOLA RD, TL CARRIAGE RD TO END, NEXT TO LAST LOT ON LEFT

SUBDIVISION BLOCK / SECTION LOT LOT AREA 1.83 AC SITE CLASS PS, DESIGN FLOW 360 L.T.A.R. 0.30 gpd/ft²

Septic Tank: 1000 Gallons: STB 1012 Date 5-21-96

Pump Tank: Gallons: PT Date

Pump Make: Model Serial No

Nitrification Field: No Fields 1 Square Feet 1200 Linear Feet 400

No Lines 4 Trench Width 36" Max Trench Bottom Depth 18-36 Gravel Depth 12

✓ New System Repair System Type: I II III IV V VI

System Description: CONVENTIONAL GRAVITY

Repair System Description: CONVENTIONAL PUMP

Maintenance Agreement Required: Yes / No

✓ House/Mod. Home No. Bedrooms 3

Mobile Home No. Bathrooms 2

Business No. Employees

Other


✓ Slab Crawl Space ✓ Basement w/plumbing Basement wo/plumbing

Water Supply: ✓ Individual Community Public WELL

Comments ① KEEP SYSTEM MINIMUM 100' FROM WELL, 10' FROM PROPANE LINE, 15" FROM FOUNDATION DRAIN, 50' FROM LAKE ② USE 3 FLOW DIVIDER TEES TO ACHIEVE EQUAL DISTRIBUTION INTO EACH OF FOUR 100' LINES ON CONTOUR.

Comments

INITIAL SITE SKETCH

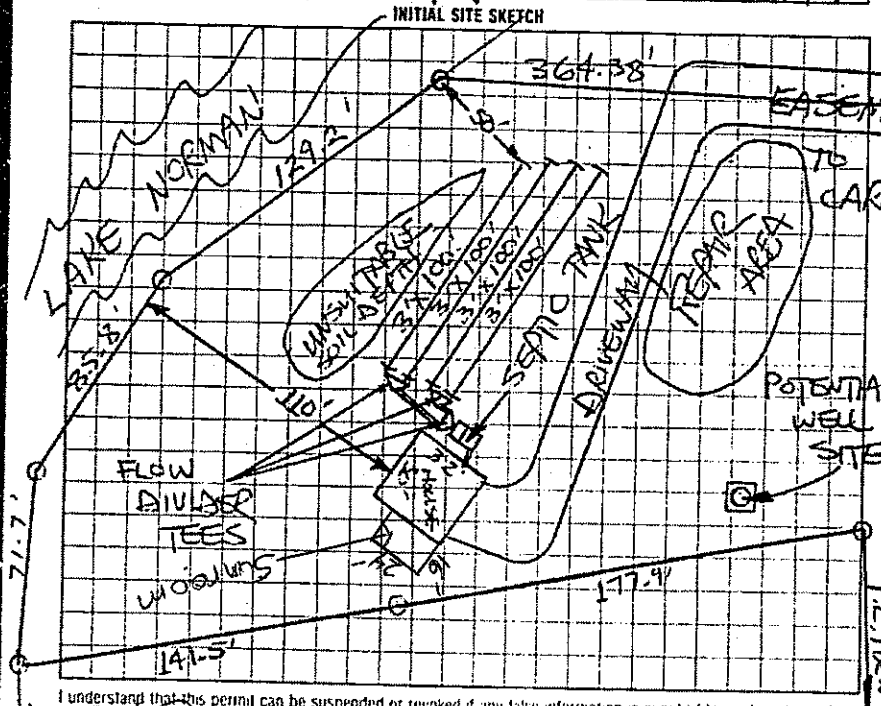

AS BUILT SKETCH

SYSTEM INSTALLED ACCORDING TO INITIAL SITE SKETCH

Location of the proposed Sunroom addition does not appear to impact the existing on-site septic system or well.**NOTE:

REHS Date: 02/17/14

ICHD-Environmental Health Division

I understand that this permit can be suspended or revoked if any false information is supplied toward securing the permit, any unauthorized changes are made to the site/any unauthorized changes are made in the installation of the system

AUTHORIZATION TO CONSTRUCT IS VALID FIVE (5) YEARS FROM DATE OF ISSUANCE. IMPROVEMENT PERMIT HAS NO EXPIRATION DATE.

Signed

Improvement Permit by: AUTHORIZATION TO CONSTRUCT by STEVE HEDRICK date 3-18-96

WHITE COPY

Installed by TOMMY FRYE

Certificate of Completion by STEVE HEDRICK date 3-18-96

INSPECTOR COPY (PINK) GREEN

Operation Permit by STEVE HEDRICK date 8-21-96

OWNER COPY (FINAL) YELLOW

INSPECTOR COPY (INITIAL) PINK

OWNER COPY (INITIAL) GOLD

5 9 7 2 0 0