IREDELL COUNTY HEALTH DEPARTMENT

STATESVILLE 704-878-5305 MOORESVILLE 704-664-5281

IMPROVEMENT PERMIT / CERTIFICATE OF COMPLETION / OPERATION PERMIT / EXISTING SYSTEM INSPECTION

PROPERTY DESCRIPTION NO. 23246 DATE 3-18-96 TAX MAP NO. 3N-A-20 Watershed ☑ IV-CA ☐ No

OWNER OR CONTRACTOR JOHN SWAIM PHONE: Business (910) 744-7404 Home

ADDRESS RT. 4, BOX 396, EAST BEND, NC 27018

LOCATION BUFFALO SHOALS RD, TR EUFOLA RD, TL CARRIAGE RD TO END, NEXT TO LAST LOT ON LEFT

SUBDIVISION BLOCK / SECTION LOT LOT AREA 1.83 AC SITE CLASS PS DESIGN FLOW 360 L.T.A.R. 0.30 GPD/FT²

Septic Tank: 1000 Gallons; STB 1012 Date 5-21-96
Pump Tank: Gallons; PT Date
Pump Make: Model Serial No
Nitrification Field: No Fields 1 Square Feet 1200 Linear Feet 400
No Lines 4 Trench Width 36" Max Trench Bottom Depth 18-36 Gravel Depth 12

☑ New System ☐ Repair System Type: I II III IV V VI
System Description: CONVENTIONAL GRAVITY
Repair System Description: CONVENTIONAL PUMP
Maintenance Agreement Required: Yes ☑ No


☑ House/Mod. Home No. Bedrooms 3
☐ Mobile Home No. Bathrooms 2
☐ Business No. Employees
☐ Other
☑ Slab ☐ Crawl Space ☑ Basement w/plumbing ☐ Basement wo/plumbing

Water Supply:
☑ Individual
☐ Community
☐ Public
WELL

Comments ① KEEP SYSTEM MINIMUM 100' FROM WELL, 10' FROM PROPERTY LINE, 15" FROM FOUNDATION DRAIN, 50' FROM LAKE
② USE THREE FOUR DIVIDER TEES TO ACHIEVE EQUAL DISTRIBUTION INTO EACH OF FOUR 100' LINES ON CONTOUR.

Comments

INITIAL SITE SKETCH

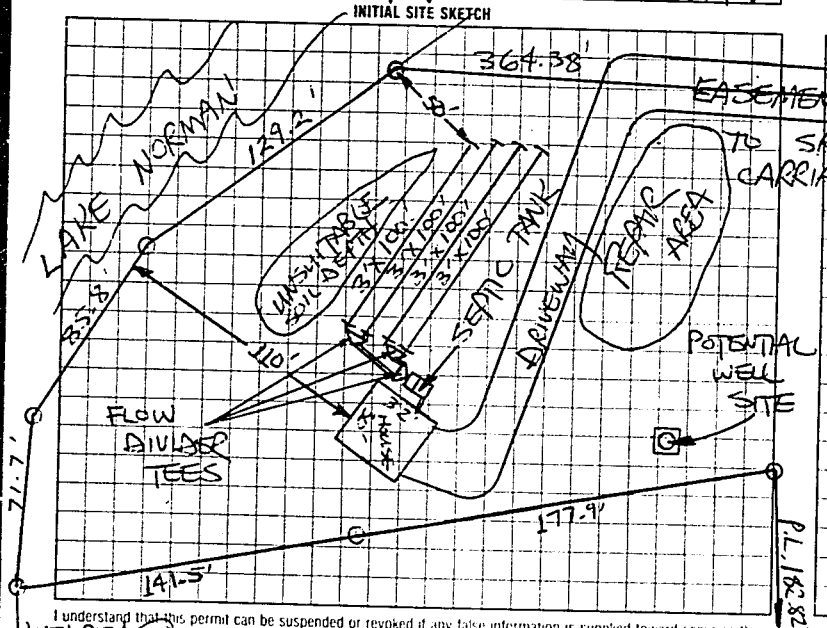

AS BUILT SKETCH

SYSTEM INSTALLED ACCORDING TO INITAL SITE SKETCH

I understand that this permit can be suspended or revoked if any false information is supplied toward securing the permit any unauthorized changes are made to the site/any unauthorized changes are made in the installation of the system

AUTHORIZATION TO CONSTRUCT IS VALID FIVE (5) YEARS FROM DATE OF ISSUANCE. IMPROVEMENT PERMIT HAS NO EXPIRATION DATE.

Signed [signature]

Improvement Permit by: STEVE HEDRICK date 3-18-96
AUTHORIZATION TO CONSTRUCT
HEALTH DEPT COPY WHITE

Certificate of Completion by: STEVE HEDRICK date 3-18-96
INSPECTION COPY (FINAL) GREEN

Installed by: TOMMY FRYE
Operation Permit by: STEVE HEDRICK date 8-21-96
OWNER COPY (FINAL) YELLOW

date
INSPECTION COPY (INITIAL) PINK

date
OWNER COPY (INITIAL) GOLD