650 9/2/97

IREDELL COUNTY HEALTH DEPARTMENT

STATESVILLE 704-878-5305 MOORESVILLE 704-664-5281

IMPROVEMENT PERMIT / CERTIFICATE OF COMPLETION / OPERATION PERMIT / EXISTING SYSTEM INSPECTION

PROPERTY DESCRIPTION NO. 24447 002565 DATE 9-9-97 TAX MAP NO. 3N-3-A-7 Watershed: ☑ Yes ☐ No

OWNER OR CONTRACTOR Chris Novelli PHONE: Business _____ Home 908 545 9146

ADDRESS 13 Ford Ave Somerset N.J. WSIV CA

LOCATION Eufola Rd Turn Carriage Rd TR Top of Lake 17th Lot Rt

SUBDIVISION Top of Lake BLOCK / SECTION _____ LOT 17 LOT AREA .146 acres SITE CLASS. PS DESIGN FLOW 360 L.T.A.R. .3

Septic Tank: 1000 Gallons; STB 794 Date 5-6-98

Pump Tank: _____ Gallons; PT _____ Date _____

Pump Make: _____ Model _____ Serial No. _____

Nitrification Field: No Fields 1 Square Feet 400 Linear Feet 200

No Lines 3 Trench Width 24" Max Trench Bottom Depth 60" Gravel Depth N/A

☑ New System ☐ Repair System Type: I, II, III, IV, V, VI

System Description: Deep Sand lined Trench PPB5

Repair System Description: 11 12

Maintenance Agreement Required: ☐ Yes ☑ No

☑ House/Mod. Home No. Bedrooms 3

☐ Mobile Home No. Bathrooms 2½

☐ Business No. Employees _____

☑ Other _____

☐ Slab ☐ Crawl Space ☑ Basement w/plumbing ☐ Basement wo/plumbing

Water Supply: ☑ Individual ☐ Community ☐ Public


Comments:

Use Deep Sand lined Trench Drawing Attached for setup which part of Permit.


Comments:

This Permit Replaces one issued to Jon Grigorian 9-11-96

INITIAL SITE SKETCH

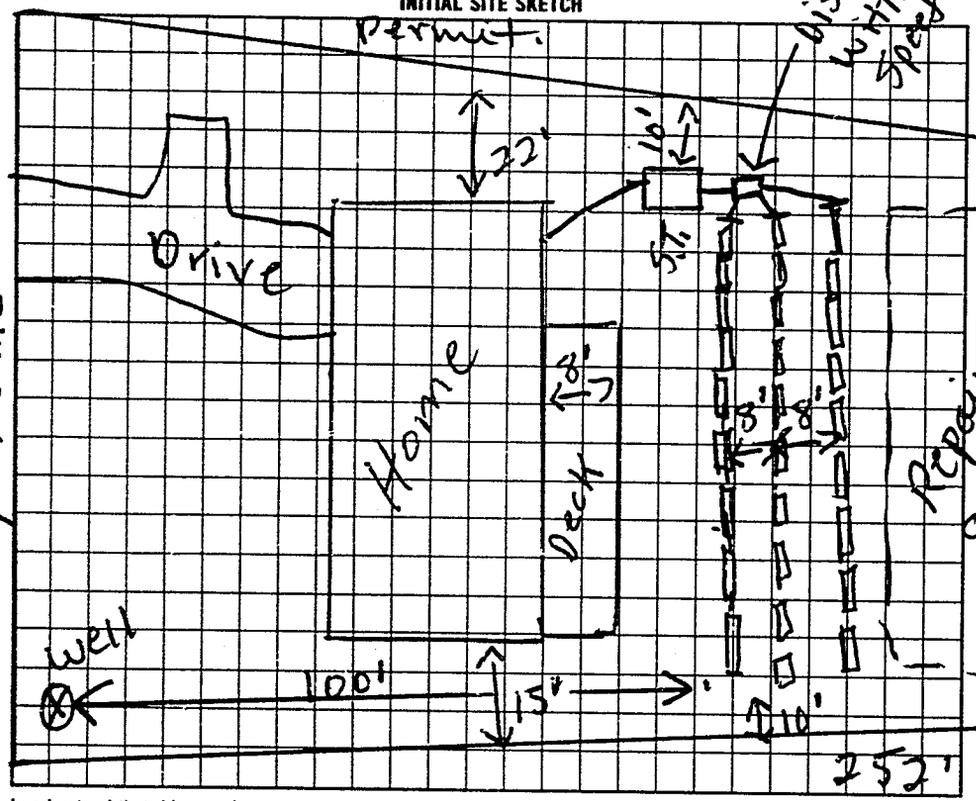

AS BUILT SKETCH

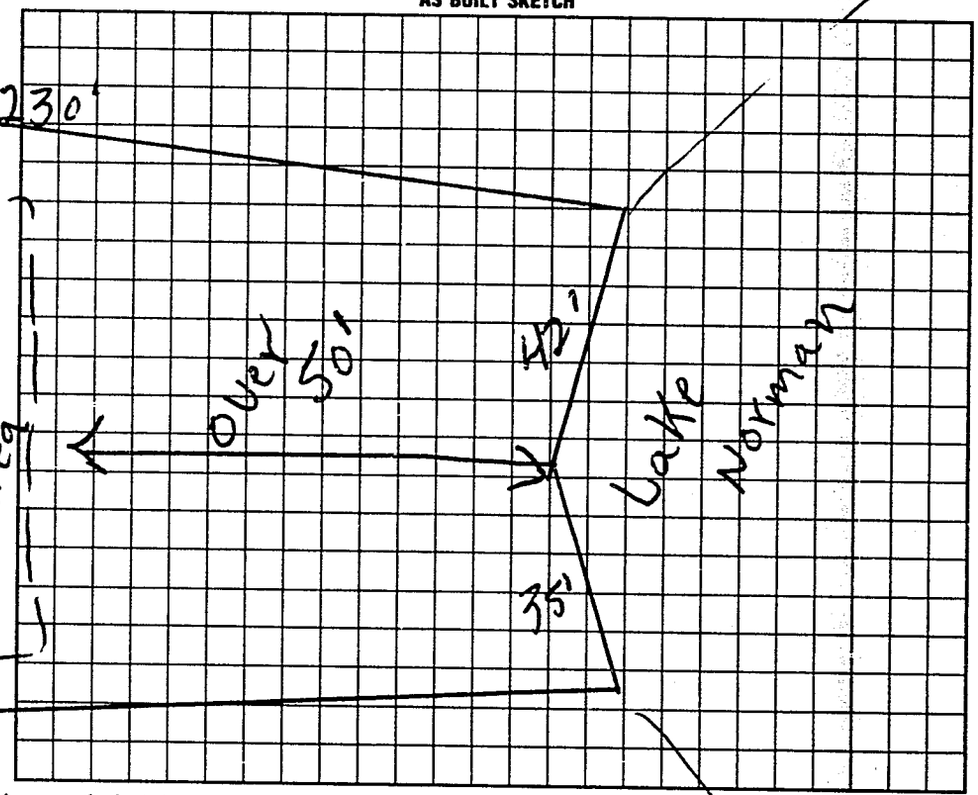

I understand that this permit can be suspended or revoked if any false information is supplied toward securing the permit/any unauthorized changes are made to the site/any unauthorized changes are made in the installation of the system. Improvement Permit is valid for 60 months from date of issuance.

Signed: Tim Whittaker Bus. C.N.

Improvement Permit by: R.C. Moore date 9-9-97

Authorization to Count Existing System Inspection by: R.C. Moore date 9-9-97

Installed by: Tim Ammons

Certificate of Completion by: _____ date _____

Operation Permit by: R.C. Moore date 9-9-97

HEALTH DEPT. COPY: WHITE INSPECTION COPY (FINAL): GREEN OWNER COPY (FINAL): YELLOW INSPECTION COPY (INITIAL): PINK OWNER COPY (INITIAL): GOLD

Authorization to count Expires 60 mos from issue

66200