# IREDELL COUNTY HEALTH DEPARTMENT

STATESVILLE 704-878-5305 CI MOORESVILLE 704-664-5281

## IMPROVEMENT PERMIT / AUTHORIZATION TO CONSTRUCT / OPERATION PERMIT / EXISTING SYSTEM INSPECTION

PERMIT# 106845 PIN# 4701-88-8455 DATE 6/19/02

OWNER OR CONTRACTOR Morgan + Parker PHONE: Business (336) 998-7745 Home —

ADDRESS P.O. Box 151 Bethania N.C. 27010

LOCATION Buffalo Creek, @ Enfola Rd, @ Carriage Lane, @ Lake Top, 5th on Rt

SUBDIVISION Top of the Lake BLOCK / SECTION — LOT 5 LOT AREA .51 Ac SITE CLASS PS DESIGN FLOW 360 L.T.A.R. .30

Septic Tank: 1,000 Gallons; STB 794 Date 5-13-02
Pump Tank: — Gallons; PT — Date —
Pump Make: — Model — Serial No —
Nitrification Field: No Fields 1 Square Feet Easy to 1,200 Linear Feet 300
No Lines 4 Trench Width 36" Max Trench Bottom Depth 36" Gravel Depth N/A

[X] New System [ ] Repair System Type: I, II, III, IV, V, VI
System Description: Gravity 25% Reduction
Repair System Description: Pump, 25% Reduction
Maintenance Agreement Required: [ ] Yes [ ] No

[X] House/Mod Home No Bedrooms 3
[ ] Mobile Home No. Bathrooms 2
[ ] Business No Employees —
[ ] Other —
[ ] Slab [ ] Crawl Space [X] Basement w/plumbing [ ] Basement wo/plumbing

Water Supply: [X] Individual [ ] Public [ ] Community


Comments/Conditions:

Scale 1" = 60'


Comments/Conditions:

- Zabel Filter Installed
- S.T. Riser Installed
- Installed 300 ft E-Z-Flow System.

INITIAL SITE SKETCH

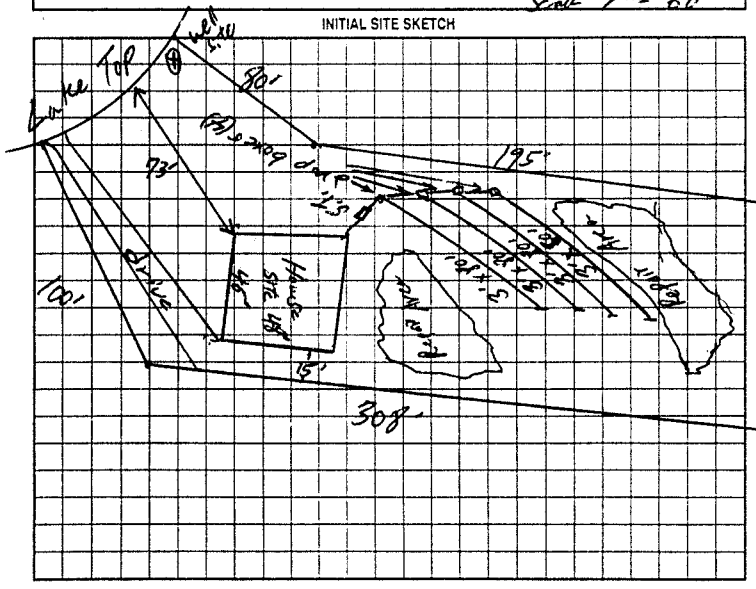


AS BUILT SKETCH Not To Scale

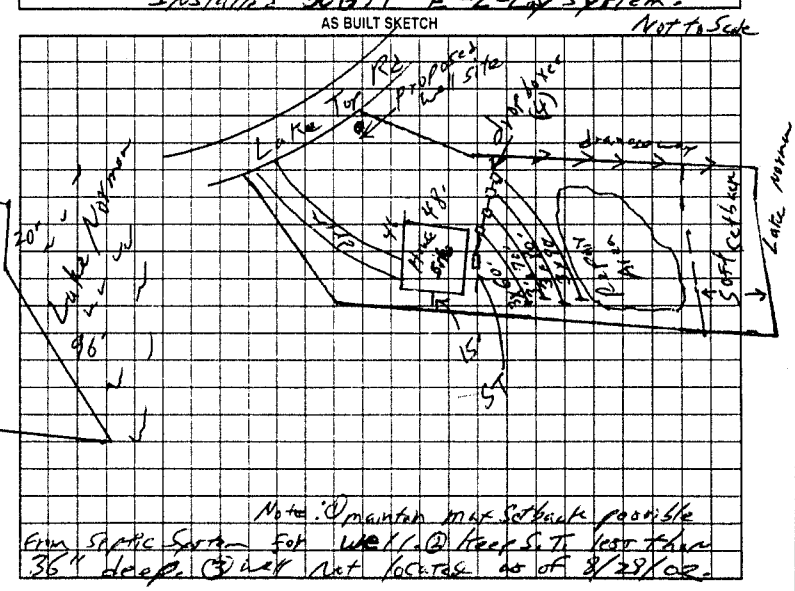



Permit can be suspended or revoked if any false information is supplied toward securing the permit/any unauthorized changes are made to the site any unauthorized changes are made in the installation of the system. Improvement Permit with plat valid without expiration. Improvement Permit with site plan valid for sixty months. Authorization to Construct is valid for a period equal to that of Improvement Permit – not to exceed sixty months

Signed: [X] Jim Morgan date 5.6.02 Installed by: E. J. Ervin

Improvement Permit by: William O. Johnson date 6/19/02 Operation Permit by: William O. Johnson REI date 8/28/02

Authorization to Construct by: William O. Johnson date 6/19/02 Existing System Inspection by: — date —

HEALTH DEPT COPY WHITE OWNER COPY (FINAL) YELLOW OWNER COPY (INITIAL) PINK