IREDELL COUNTY HEALTH DEPARTMENT

STATESVILLE 704-878-5305 MOORESVILLE 704-664-5281

IMPROVEMENT PERMIT / AUTHORIZATION TO CONSTRUCT / OPERATION PERMIT / EXISTING SYSTEM INSPECTION

PERMIT# 82857 PIN# 4701888750

OWNER OR CONTRACTOR Michael HARTNESS PHONE: Business 488 2501 Home 664 5978 DATE July 30, 99

ADDRESS 188 Sagamore Rd Mooresville NC

LOCATION Buffalo Shoals (R) E. Fola (L) Carriage Rd on Right Through Field Before Lake Top Lane

SUBDIVISION Top of the Lake BLOCK / SECTION LOT LOT AREA 1.5 Ac SITE CLASS. PS DESIGN FLOW 360 L.T.A.R. .3

Septic Tank: 1000 Gallons: STB 1012 Date 6.8.99

Pump Tank: Gallons: PT Date

Pump Make: Model Serial No.

Nitrification Field: No Fields 1 Square Feet 1200 Linear Feet 400

No Lines 5 Trench Width 36" Max Trench Bottom Depth 36" Gravel Depth 12"

☒ New System ☐ Repair System Type: I. II. III. IV. V. VI

System Description: Conv Gravity

Repair System Description: 25-50% Reduction Gravity

Maintenance Agreement Required: ☐ Yes ☒ No

☐ House/Mod. Home ☒ Mobile Home ☐ Business ☐ Other

No. Bedrooms 3 No. Bathrooms 2 No. Employees

☐ Slab ☐ Crawl Space ☐ Basement w/plumbing ☐ Basement wo/plumbing

Water Supply: ☒ Individual ☐ Public ☐ Community WELL

Comments/Conditions


1. INSTALL on CONTOUR
2. LOCATE Septic TANK SO TO Allow GRAVITY Feed From BASEMENT
3. Any under GRADing may LimiT REPAIR AREA And System INSTALLed
4. MAINTAIN 50' back From WATERS Edge - 50 FT

Comments/Conditions


of FUTURE home

INITIAL SITE SKETCH

1"=50' Scale

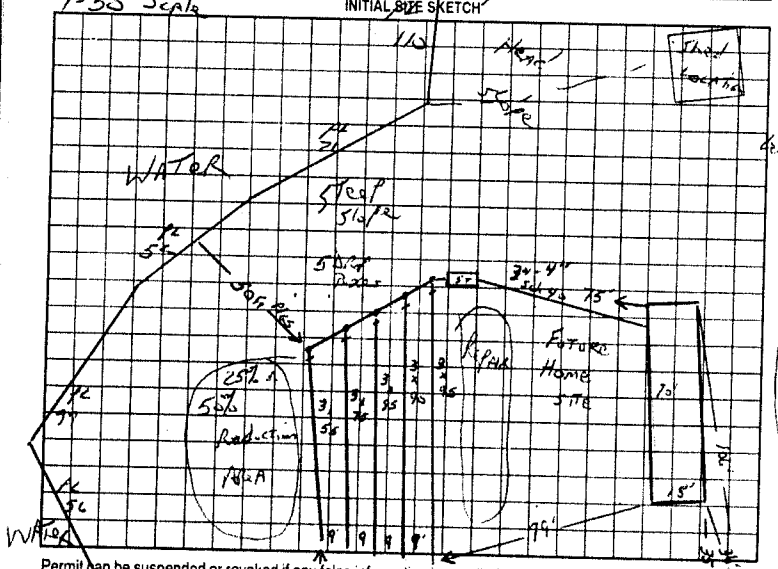

AS BUILT SKETCH

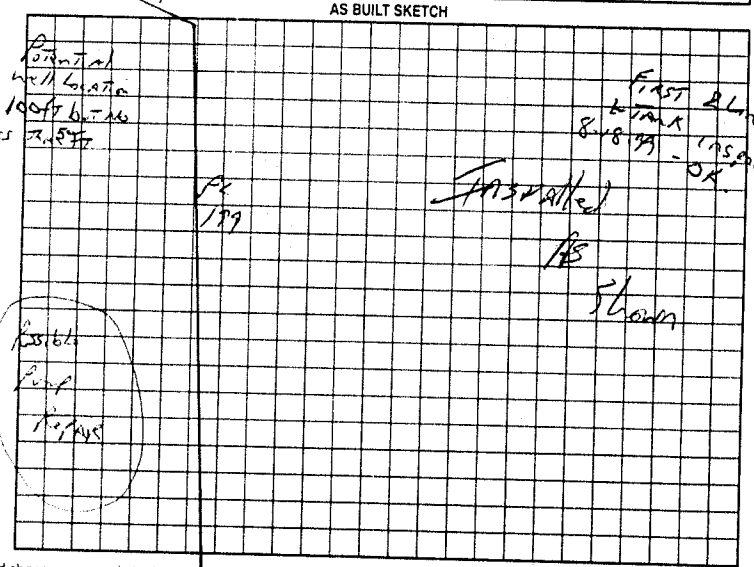

Permit can be suspended or revoked if any false information is supplied toward securing the permit/any unauthorized changes are made to the site/any unauthorized changes are made in the installation of the system. Improvement Permit with plat valid without expiration. Improvement Permit with site plan valid for sixty months. Authorization to Construct is valid for a period equal to that of Improvement Permit – not to exceed sixty months.

Signed: Michael Hartness date 8-2-99

Improvement Permit by: Jc Potter date 7/30/99

Authorization to Construct by: Jc Potter date 7/30/99

Installed by: Michael Hartness Owner

Operation Permit by: Jc Potter date 8-19-99

Existing System Inspection by: date

HEALTH DEPT. COPY: WHITE OWNER COPY (FINAL): YELLOW OWNER COPY (INITIAL): PINK