IREDELL COUNTY HEALTH DEPARTMENT

STATESVILLE 704-878-5305 CI MOORESVILLE 704-664-5281

IMPROVEMENT PERMIT / AUTHORIZATION TO CONSTRUCT / OPERATION PERMIT / EXISTING SYSTEM INSPECTION

PERMIT# 133469 PIN# 4701954778 DATE 3-3-06

OWNER OR APPLICANT Jeffery Gregory PHONE: Business _____ Home 704 872 9319

ADDRESS 221 Grayrock Dr.

LOCATION Buffalo Shoals S to (R) on Gray Rock, Lot on (L) at end of cul-de-sac

SUBDIVISION Grayrock Shoals BLOCK / SECTION ~~3~~ LOT 30 LOT AREA .86 SITE CLASS. P.S DESIGN FLOW 360 L.T.A.R. .3

Septic Tank: 1000 Gallons; STB 1012 Date 3-19-06
Pump Tank: _____ Gallons; PT _____ Date _____
Pump Make: _____ Model _____ Serial No. _____
Nitrification Field: No Fields 1 Square Feet 1200 Linear Feet 300'
No Lines 3 Trench Width 36" Max Trench Bottom Depth 34"

☒ New System ☐ Repair ☐ Expansion System Type: I (II) III IV V VI
System Description: 25% Reduction Gravity
Repair System Description: 25% Reduction
Maintenance Agreement Required: ☐ Yes ☒ No

☒ House/Mod. Home ☐ Mobile Home ☐ Business ☐ Other
No. Bedrooms 3 No. Persons ___ No. Employees ___


Water Supply: ☒ Individual ☐ Public ☐ Community

Gravel Depth n/a ☒ Gravity ☐ Pressure ☐ Slab ☐ Crawl Space ☒ Basement w/plumbing ☐ Basement wo/plumbing


Comments:/Conditions:

Comments:/Conditions:
Yellow Tuff-Tite
no risers

INITIAL SITE SKETCH

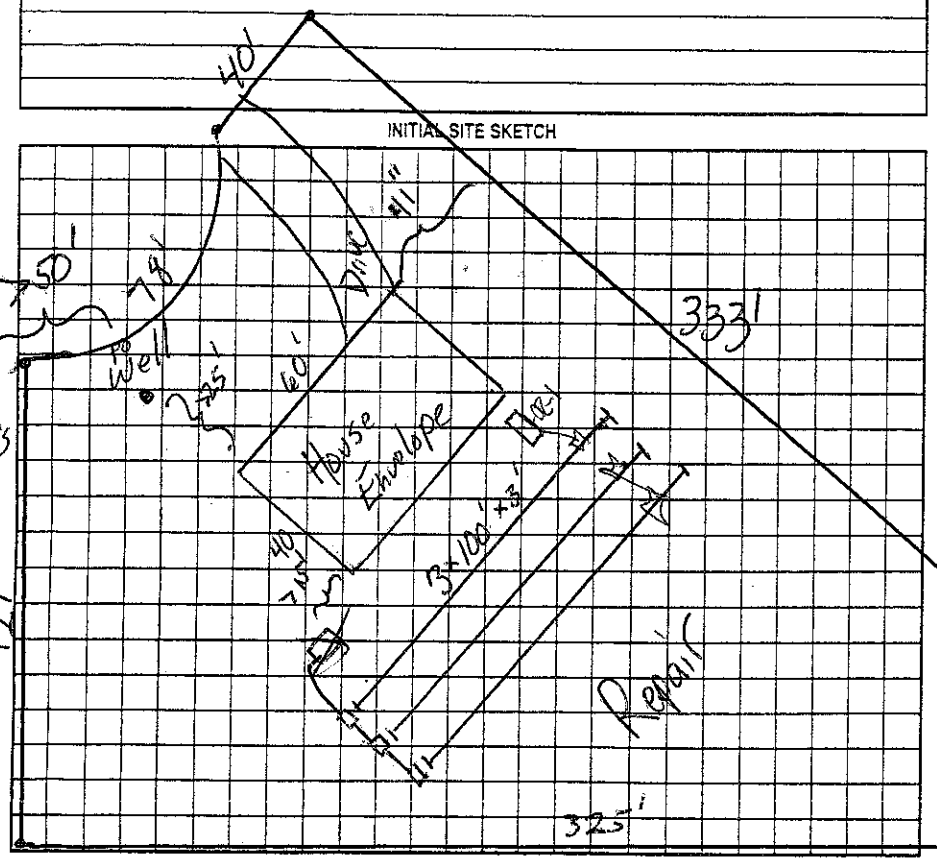

AS BUILT SKETCH

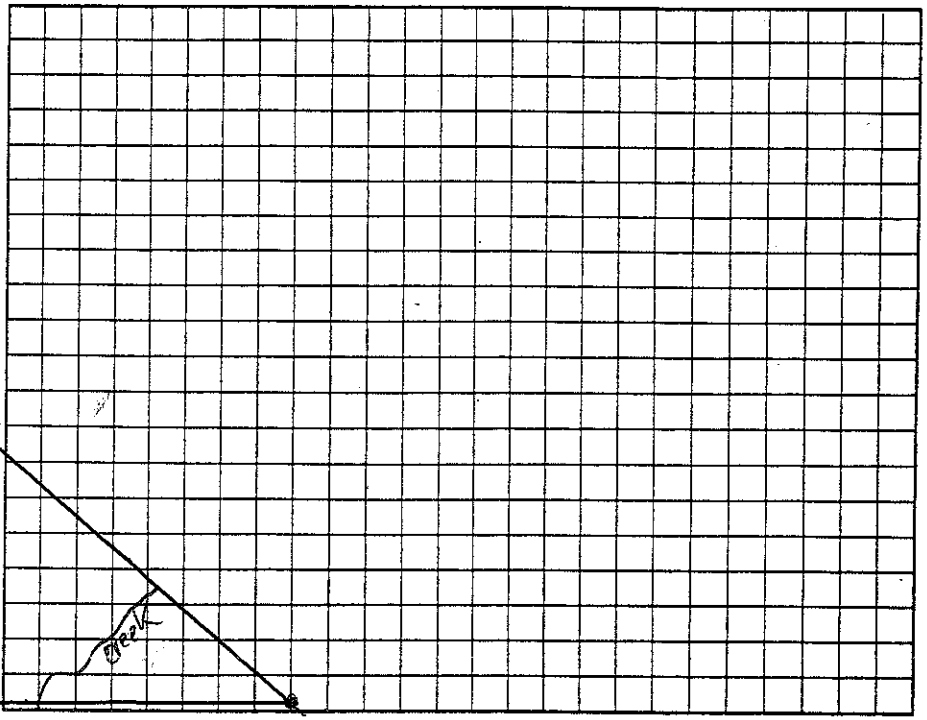

Permit can be suspended or revoked if any false information is supplied toward securing the permit/any unauthorized changes are made to the site/any unauthorized changes are made in the installation of the system. Improvement Permit with plat valid without expiration ☐ Improvement Permit with site plan valid for sixty months ☒ Authorization to Construct is valid for a period equal to that of Improvement Permit – not to exceed sixty months.

Signed: Jeff Gregory date 3-3-06
Improvement Permit by: _____ date 3-3-06
Authorization to Construct by: _____ date 3-7-06

Installed by: A-1 Backhoe
Operation Permit by: _____ date 7-27-06
Existing System Inspection by: _____ date _____

HEALTH DEPT. COPY: WHITE OWNER COPY (FINAL): YELLOW OWNER COPY (INITIAL): PINK