IREDELL COUNTY HEALTH DEPARTMENT - *ENVIRONMENTAL HEALTH* ☒ STATESVILLE OFFICE 704-878-5305 ☐ MOORESVILLE OFFICE 704-664-5281

IMPROVEMENT PERMIT / AUTHORIZATION TO CONSTRUCT / OPERATION PERMIT / EXISTING SYSTEM INSPECTION

PERMIT # 170352 PIN # 4701-96-2000 DATE 1/31/12

OWNER Vincent Cherry Jr. APPLICANT: Derek Osborne PHONE: Home/Cell # 704 902 3084 Business #

SITE ADDRESS 222 Grayrock Dr. OWNER / APPLICANT ADDRESS 222 Grayrock

SITE DIRECTIONS S on Buffalo Shoals, (R) on Grayrock Shoals (just before river), lot on right.

SUBDIVISION Grayrock Shoals BLOCK / SECTION LOT # 27 LOT AREA 1.052 DESIGN FLOW 240 L.T.A.R. .3

Septic Tank 1000 (Ex) Gallons: STB 826 (Ex) Date 6-15-97

Pump Tank 1200 (Ex) Gallons: PT 40 (Ex) Date 5-2-97

Pump Make Zoeller (Ex) Model E-185-B Serial #

No. Nitrification Fields: 1 No. Lines 3 (Ex) Linear Feet 200 (Ex)

Trench Width 36" Max. Trench Bottom Depth 36" Gravel Depth n/a

☒ New System ☐ Repair ☐ Expansion System Type I II (III) IV V VI

System Description: Pump to II Chamber

Repair System Description:

Maintenance Agreement Required ☐ YES ☒ NO

☐ GRAVITY ☒ PRESSURE

☒ Residence No. Bedrooms 2

☐ Business No. Persons

☐ Other No. Employees


☐ Slab ☐ Crawl Space

☒ Basement w/plumbing ☐ Basement w/o plumbing


Water Supply: ☒ Private ☐ Public ☐ Community

Comments / Conditions: Relocate Supply Line along property line

INITIAL SITE SKETCH

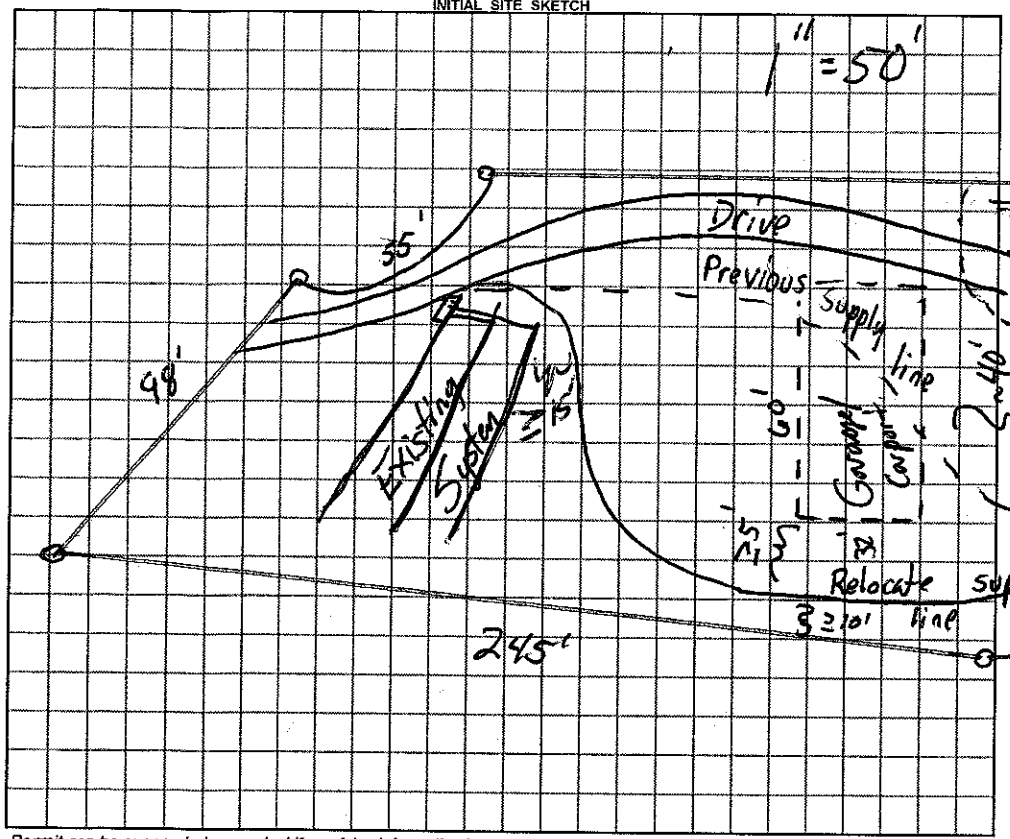

AS BUILT SKETCH

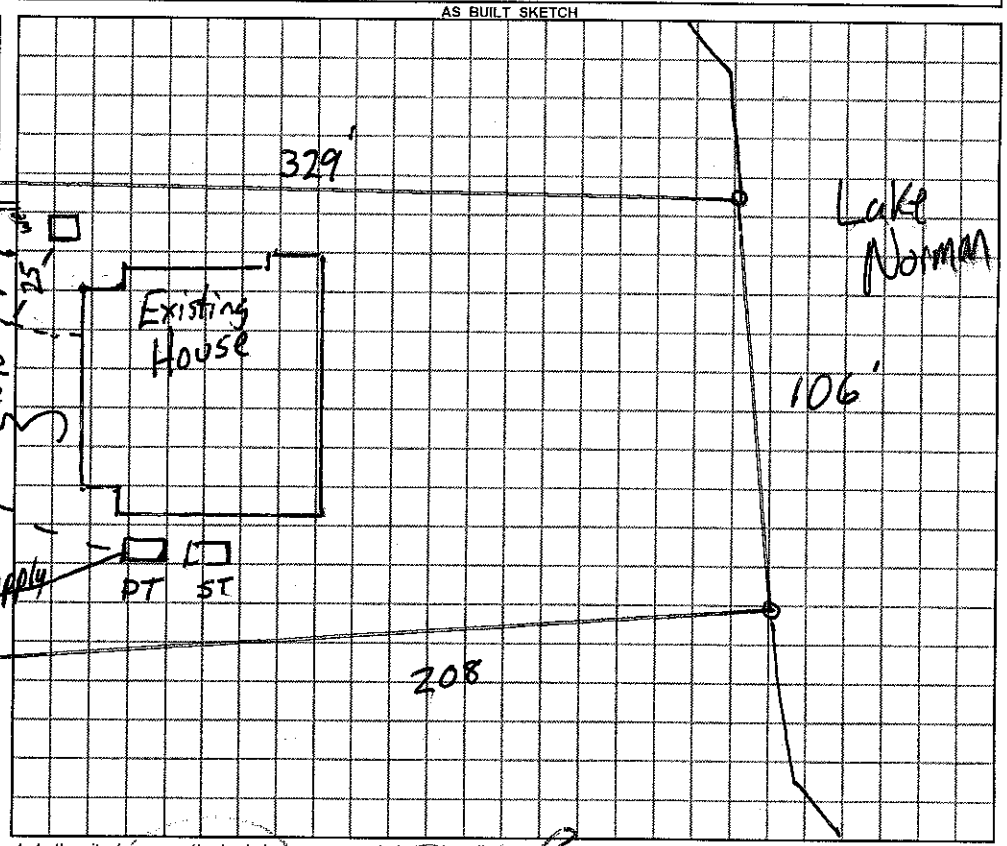

Permit can be suspended or revoked if any false information is supplied toward securing the permit / any unauthorized changes are made to the site / any unauthorized changes are made in the installation of the system.

☐ ***IMPROVEMENT PERMIT*** *with plat valid without expiration.* ☒ ***IMPROVEMENT PERMIT*** *with plat valid without expiration. site plan valid 60 mo.* ☒ ***AUTHORIZATION TO CONSTRUCT*** *valid for period equal to IMPROVEMENT PERMIT--not to exceed 60 mo.*

Owner / Applicant Signature: Derrick Osborne Date 2-1-12 Installed by: Kelly Wellons

IMPROVEMENT PERMIT by: REHS Date 1-31-12 OPERATION PERMIT by: REHS Date 2-8-12

AUTHORIZATION TO CONSTRUCT by: REHS Date 1-31-12 Existing System Inspected by: REHS Date

YOU SHOULD CONTACT A LOCATOR SERVICE PRIOR TO ANY EXCAVATION

White Copy -- Environmental Health YELLOW COPY (Final) Owner / Applicant PINK COPY (Initial) Owner / Applicant