IREDELL COUNTY HEALTH DEPARTMENT

STATESVILLE 704-878-5305 MOORESVILLE 704-664-5281

IMPROVEMENT PERMIT / CERTIFICATE OF COMPLETION / OPERATION PERMIT / EXISTING SYSTEM INSPECTION

PROPERTY DESCRIPTION NO. 2-H993 06616 DATE 5-14-97 TAX MAP NO. 3N-4-A-27 Watershed: ☑ Yes ☐ No

OWNER OR CONTRACTOR Donald E. Thompson PHONE: Business Home 704 664 2711 INSIDE CA

ADDRESS 16241 Rock spring Rd mooresville

LOCATION Buffalo Shoales Rd TR Gray Rock Shoales Init lot on NE 340

SUBDIVISION Gray Rock BLOCK / SECTION LOT 27 LOT AREA 1.04 acres SITE CLASS. PS DESIGN FLOW 360 L.T.A.R. .3

Septic Tank: 1000 Gallons; STB 826 Date 6-15-97

Pump Tank: 1200 Gallons; PT 40 Date 5-2-97

Pump Make: Zoeller Model E 184 B Serial No. B150N4 097

Nitrification Field: No Fields ___ Square Feet 600 Linear Feet 200

No Lines 3 Trench Width 36" Max Trench Bottom Depth 36" Gravel Depth N/A

☑ New System ☐ Repair System Type: I, II, III, IV, V, VI

System Description: Pump To Chambers

Repair System Description: " " "

Maintenance Agreement Required: ☐ Yes ☑ No

☑ House/Mod. Home No. Bedrooms 2

☐ Mobile Home No. Bathrooms 2

☐ Business No. Employees ___

☐ Other

☐ Slab ☐ Crawl Space ☑ Basement w/plumbing ☐ Basement wo/plumbing


Water Supply: ☑ Individual ☐ Community ☐ Public

Comments: Replace permit issued To High Shoals Development 9-20-96 Current owner using 2 bedroom House


Comments: 7-16-97 Called Tanks and drain lines - OK and Need 2nd riser on pump tank JM - Checked Floats, 11-24 - MO Checked Press.

INITIAL SITE SKETCH

See attached sheets for P.T. Pressure manifold which are part of This Permit.

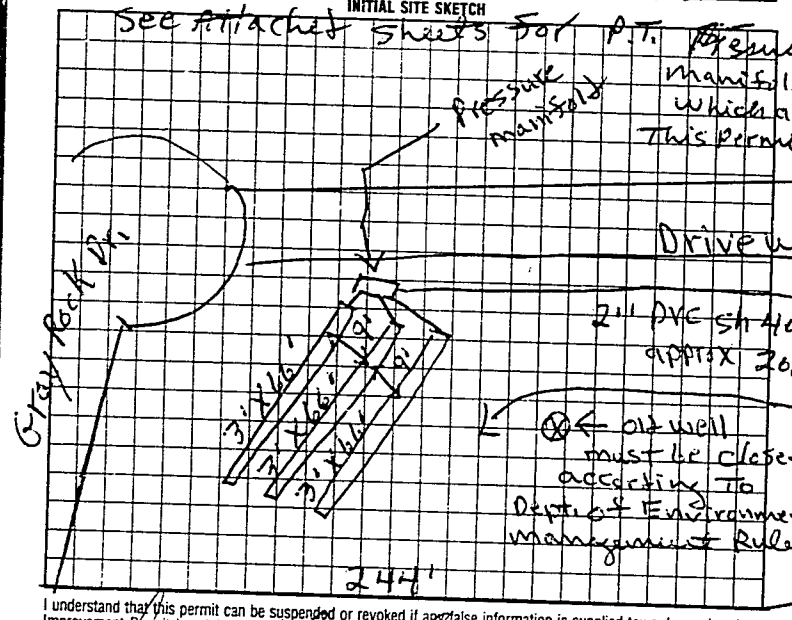

AS BUILT SKETCH

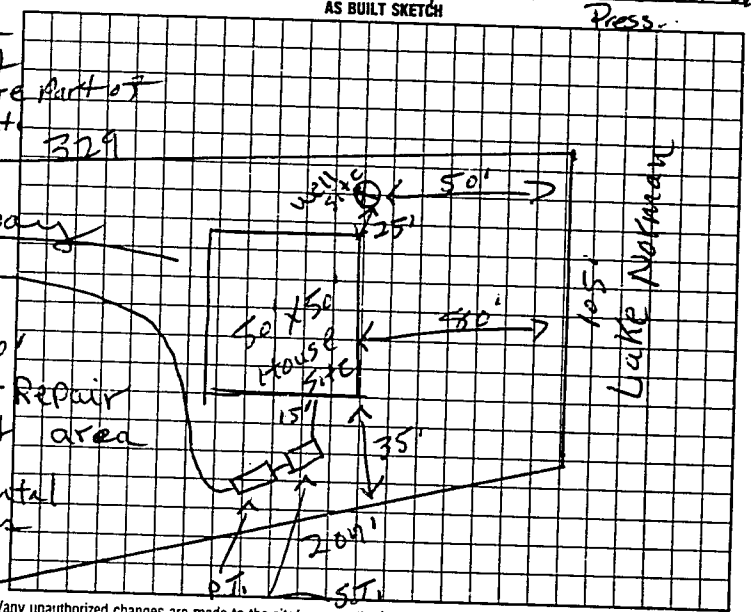

I understand that this permit can be suspended or revoked if any false information is supplied toward securing the permit/any unauthorized changes are made to the site/any unauthorized changes are made in the installation of the system. Improvement Permit is valid for 60 months from date of issuance.

Signed: Denise D. Smith Lowry Construction Co.

Improvement Permit by: P.C. Moore date 5-14-97

Existing System Inspection by: P.C. Moore date 5-14-97

Installed by: G+M Enterprises

Certificate of Completion by: ___ date ___

Operation Permit by: Mary C Ott RS date 12-19-97

Authorization to cont Expires 60 mos from issue to cont.

HEALTH DEPT COPY WHITE INSPECTION COPY (FINAL) GREEN OWNER COPY (FINAL) YELLOW INSPECTION COPY (INITIAL) PINK OWNER COPY (INITIAL) GOLD