IREDELL COUNTY HEALTH DEPARTMENT

STATESVILLE 704-878-5305 (X) MOORESVILLE 704-664-5281

IMPROVEMENT PERMIT / AUTHORIZATION TO CONSTRUCT / OPERATION PERMIT / EXISTING SYSTEM INSPECTION

PERMIT# 106233 PIN# 4701-96-7328 DATE 5/31/02

OWNER OR CONTRACTOR High Shoals Development Inc. PHONE: Business (704) 873-7700 Home —

ADDRESS 1805 St Friet Road Statesville N.C. 28625

LOCATION Buffalo Shoals 3½ miles past Old Mtn. Rd, (R) Gray Rock Drive, (R) High Shoals 2nd on Right

SUBDIVISION Gray Rock Sub BLOCK / SECTION — LOT 16 LOT AREA .80 Ac. SITE CLASS P5 DESIGN FLOW 360 L.T.A.R. .30

Septic Tank: 1,000 Gallons; STB 1012 Date 10-18-03
Pump Tank: — Gallons; PT — Date —
Pump Make: — Model — Serial No. —
Nitrification Field: No Fields 1 Square Feet 1200 Linear Feet 400'
No Lines 4@100' Trench Width 36" Max Trench Bottom Depth 36" Gravel Depth 12"

[X] New System [ ] Repair System Type: [I] II, III, IV, V, VI
System Description: Gravity, Conventional
Repair System Description: Pump, LP Panels
Maintenance Agreement Required: [ ] Yes [X] No


[X] House/Mod. Home No. Bedrooms 3
[ ] Mobile Home No. Bathrooms 2
[ ] Business No. Employees —
[ ] Other —
[ ] Slab [X] Crawl Space [ ] Basement w/plumbing [ ] Basement wo/plumbing

Water Supply: [X] Individual [ ] Public [ ] Community

Comments:/Conditions: ① Install lines on Contour ② maintain proper setbacks

Comments:/Conditions: SEPTIC TANK WITH MARKER INSTALLED USING "TUF-TITE" FILTER

INITIAL SITE SKETCH

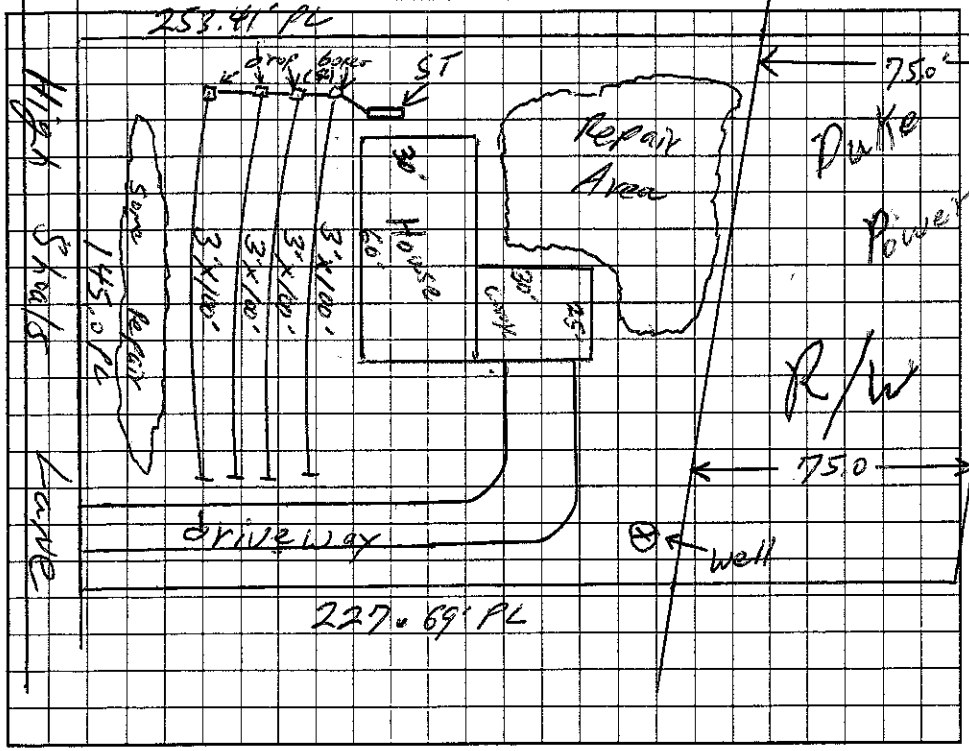

AS BUILT SKETCH

SYSTEM INSTALLED ACCORDING TO INITIAL SITE SKETCH

Permit can be suspended or revoked if any false information is supplied toward securing the permit/any unauthorized changes are made to the site/any unauthorized changes are made in the installation of the system. Improvement Permit with plat valid without expiration. Improvement Permit with site plan valid for sixty months. Authorization to Construct is valid for a period equal to that of Improvement Permit – not to exceed sixty months.

Signed: C. D. [illegible] VP date 5/31/02
Improvement Permit by: William A. Johnson date 5/31/02
Authorization to Construct by: William A. Johnson date 5/31/02

Installed by: PIEDMONT BACKHOE
Operation Permit by: STEVE HENDRICK date 4-20-04
Existing System Inspection by: — date —

HEALTH DEPT. COPY: WHITE OWNER COPY (FINAL): YELLOW OWNER COPY (INITIAL): PINK