IREDELL COUNTY HEALTH DEPARTMENT

STATESVILLE 704-878-5305 MOORESVILLE 704-664-5281

IMPROVEMENT PERMIT / CERTIFICATE OF COMPLETION / OPERATION PERMIT / EXISTING SYSTEM INSPECTION

PROPERTY DESCRIPTION NO. 23594 DUKE DATE 7-28-97 TAX MAP NO. 3N-4-A-14

OWNER OR CONTRACTOR Larry Collins PHONE: Business Home 585 9875

ADDRESS RT 2 Box 420 Statesville NC.

LOCATION Buffalo Shoals TR Gray Rock 1/4 mi rd

SUBDIVISION Gray Rock BLOCK / SECTION LOT 14 LOT AREA 1.77 acres SITE CLASS. P5 DESIGN FLOW 360 L.T.A.R. 1.3

Watershed: ☐ Yes ☑ No

Septic Tank: 1000 Gallons; STB 1000 Date 7-31-97

Pump Tank: Gallons; PT Date

Pump Make: Model Serial No.

Nitrification Field: No Fields 1 Square Feet 1200 Linear Feet 400'

No Lines 3 Trench Width 36" Max Trench Bottom Depth 36" Gravel Depth 12"

☑ New System ☐ Repair System Type: I, II, III, IV, V, VI

System Description: Conv. Gravity

Repair System Description: Gravity Chambers

Maintenance Agreement Required: ☐ Yes ☑ No

☑ House/Mod. Home ☐ Mobile Home ☐ Business ☐ Other

No. Bedrooms 3 No. Bathrooms 2 No. Employees


☐ Slab ☑ Crawl Space ☐ Basement w/plumbing ☐ Basement wo/plumbing

Water Supply: ☑ Individual ☐ Community ☐ Public


Comments: Replaces Permit issued To ~~Issued~~ 11-96 High Shoales Development Lot 14 Gray Rock 400'

Comments:

INITIAL SITE SKETCH

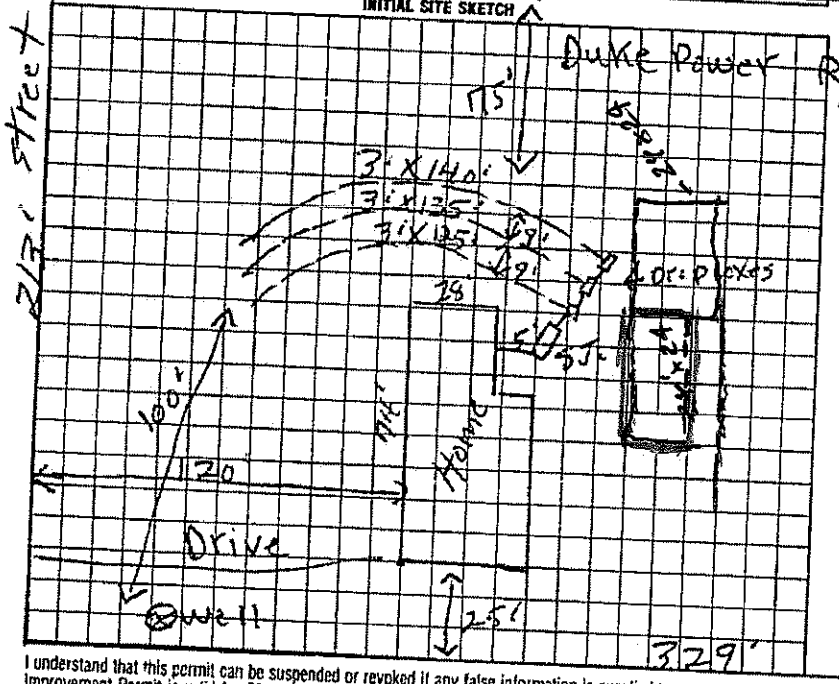

AS BUILT SKETCH

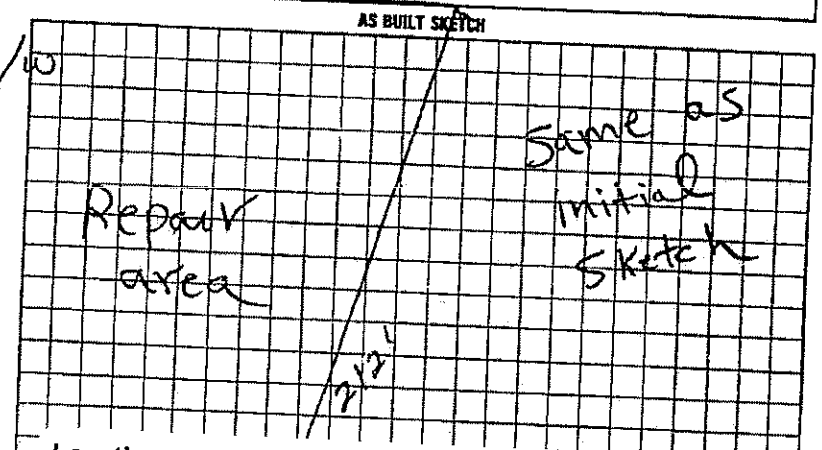

Location of the proposed ACCESSORY BUILDING addition does not appear to impact the existing on-site septic system.**NOTE: KEEP MIN. 5' FROM SYSTEM

R. STEVE HEDRICK REHS

Date: MAR 14, 2013

ICHD-Environmental Health Division

I understand that this permit can be suspended or revoked if any false information is supplied toward securing the permit/any unauthorized changes are made to the site/any unauthorized changes are made in the installation of the system. Improvement Permit is valid for 60 months from date of issuance.

Signed: Larry Collins

Improvement Permit by: L.C. Moore date 7-28-97 Installed by: Wittenburg Precast

Authorization to Construct/Existing System Approved by: L.C. Moore date 7-28-97 Certificate of Completion by: date

Operation Permit by: L.C. Moore date 9-17-97

HEALTH DEPT. COPY: WHITE INSPECTION COPY (FINAL): GREEN OWNER COPY (FINAL): YELLOW INSPECTION COPY (INITIAL): PINK OWNER COPY (INITIAL): GOLD

Authorization to Construct Expires 60 mos From issue.