IREDELL COUNTY HEALTH DEPARTMENT

STATESVILLE 704-878-5305 MOORESVILLE 704-664-5281

IMPROVEMENT PERMIT / CERTIFICATE OF COMPLETION / OPERATION PERMIT / EXISTING SYSTEM INSPECTION

PROPERTY DESCRIPTION NO. 2350A DATE 9-6-96 TAX MAP NO. 3N-3-A-17 Watershed: ☑ Yes ☐ No

OWNER OR CONTRACTOR Jon Grigorian PHONE: Business 664 3400 Home

ADDRESS 386 Williamson Rd Mooresville, N.C.

LOCATION Buffalo Shoals TR Enfield Rd TL Carriage Lane Rt Top of Lake 1/8mi Left

SUBDIVISION Top of Lake BLOCK / SECTION LOT 17 LOT AREA .5 acres SITE CLASS. PS DESIGN FLOW 240 L.T.A. .13

Septic Tank: 1000 Gallons; STB 1012 Date 7-22-97

Pump Tank: 1000 Gallons; PT 17 Date 4-26-97

Pump Make: Goulds Model 720 Serial No.

Nitrification Field: No Fields 4 Square Feet Linear Feet 240

No Lines 4 Trench Width 36" Max Trench Bottom Depth 36" Gravel Depth N/A

☑ New System ☐ Repair System Type: I, II, III, IV, V, VI

System Description: Pump to Chambers

Repair System Description:

Maintenance Agreement Required: ☐ Yes ☑ No

☑ House/Mod. Home No. Bedrooms 3

☐ Mobile Home No. Bathrooms 2

☐ Business No. Employees

☐ Other

☐ Slab ☐ Crawl Space ☑ Basement w/plumbing ☐ Basement wo/plumbing

Water Supply: ☑ Individual ☐ Community ☐ Public

Comments:


See Attached Sheets for manifold + Pump Tank Set up which are part of this Permit

Comments:


Model # WE0511H

Serial # C9739282

INITIAL SITE SKETCH

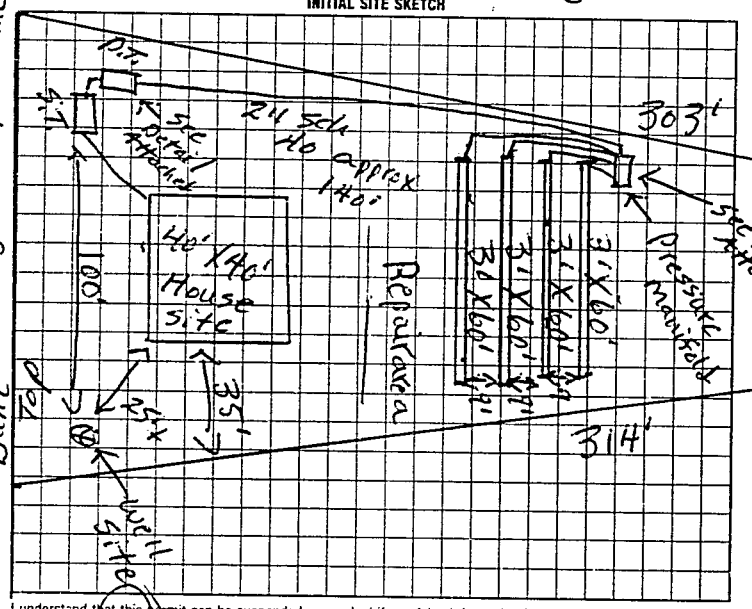

AS BUILT SKETCH

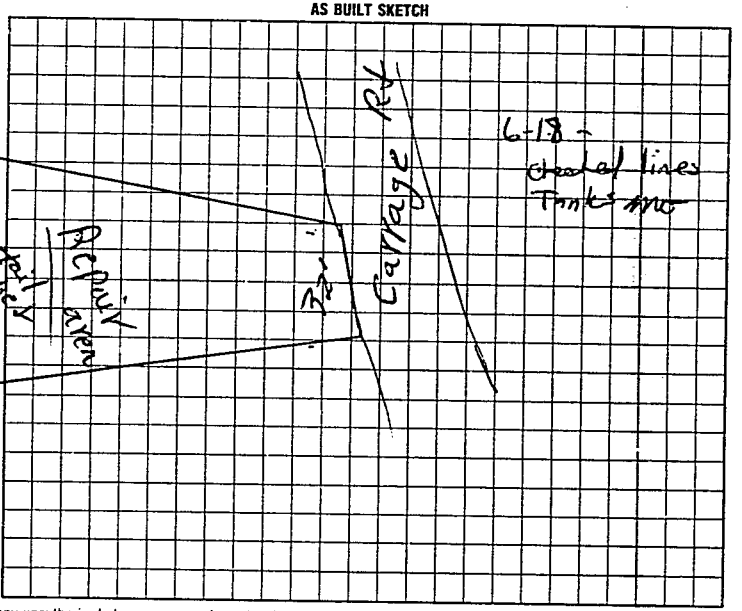

I understand that this permit can be suspended or revoked if any false information is supplied toward securing the permit/any unauthorized changes are made to the site/any unauthorized changes are made in the installation of the system.

Signed:

Improvement Permit by: P.C. Moore date 9-6-96

Existing System Inspection by: P.C. Moore date 7-6-96

Installed by: David Yount

Certificate of Completion by: date

Operation Permit by: Mary C Ott RS date 7-2-97

authorization to Co HEALTH DEPT. COPY: WHITE INSPECTION COPY (FINAL): GREEN OWNER COPY (FINAL): YELLOW INSPECTION COPY (INITIAL): PINK OWNER COPY (INITIAL): GOLD

Authorization to Const Expires 60 mon from issue

P.

Σ 6 2 0 0 0