...DELL COUNTY HEALTH DEPARTMENT

STATESVILLE 704-878-5305 MOORESVILLE 704-664-5281

IMPROVEMENT PERMIT / AUTHORIZATION TO CONSTRUCT / OPERATION PERMIT / EXISTING SYSTEM INSPECTION

PERMIT# 87087 PIN# 4701980342 DATE JAN 12-2000

OWNER OR CONTRACTOR Landco South Inc PHONE: Business 769 4020 Home

ADDRESS 3710 HASTING Rd Kernersville NC

LOCATION Old MTRd 5th (R) Celeste Eufola Rd (L) Eufola (R) CARRIAGE (R) Top of LAKE Top Lane 3rd Lot on Left

SUBDIVISION Top of the LAKE BLOCK / SECTION LOT 18/19 LOT AREA 1Ac Plus SITE CLASS PS DESIGN FLOW 360 L.T.A.R. .3

Septic Tank: 1000 Gallons; STB 354 Date 8/17/00
Pump Tank: Gallons; PT Date
Pump Make: Model Serial No.
Nitrification Field: No Fields 1 Square Feet 1200 Linear Feet 400
No Lines 5 Trench Width 36" Max Trench Bottom Depth 36" Gravel Depth 12"

☒ New System ☐ Repair System Type: I (II) III. IV. V. VI
System Description: Conv. GRAVITY
Repair System Description: Pump Red-Elim Possible
Maintenance Agreement Required: ☐ Yes ☒ No


☒ House/Mod. Home No. Bedrooms 3
☐ Mobile Home No. Bathrooms 2
☐ Business No. Employees
☐ Other
☐ Slab ☒ Crawl Space ☐ Basement w/plumbing ☐ Basement wo/plumbing

Water Supply: ☒ Individual ☐ Public ☐ Community WELL


Comments:/Conditions: INSTALL on CONTOUR
LOCATE well 100ft from Septic system Lake Top Lane

Comments:/Conditions:

INITIAL SITE SKETCH

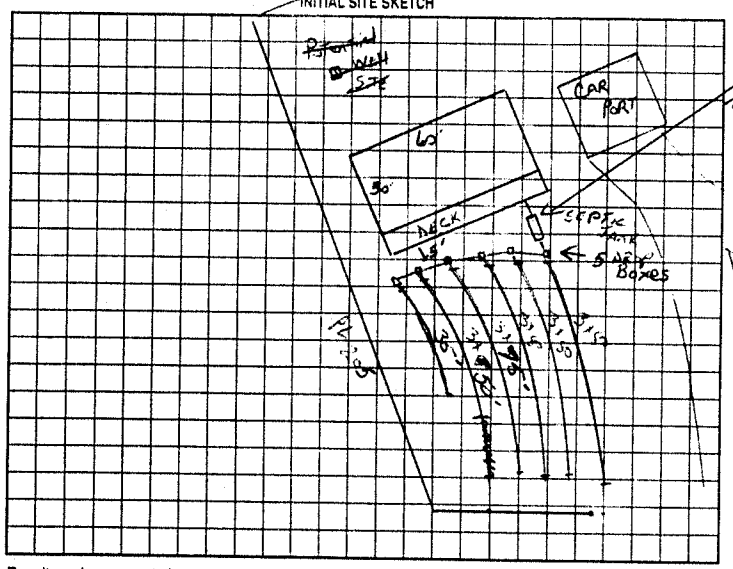

AS BUILT SKETCH

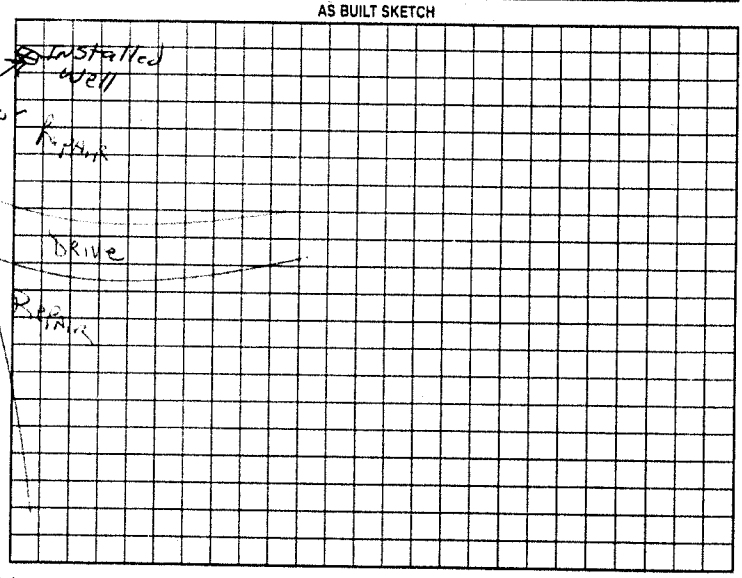

Permit can be suspended or revoked if any false information is supplied toward securing the permit/any unauthorized changes are made to the site/any unauthorized changes are made in the installation of the system. Improvement Permit with plat valid without expiration. Improvement Permit with site plan valid for sixty months. Authorization to Construct is valid for a period equal to that of Improvement Permit – not to exceed sixty months.

Signed: date 1-19-00 Installed by: G&M Enterprises

Improvement Permit by: date JAN 12 2000 Operation Permit by: RSI date 10/5/00

Authorization to Construct by: date JAN 12 2000 Existing System Inspection by: date

HEALTH DEPT. COPY: WHITE OWNER COPY (FINAL) YELLOW OWNER COPY (INITIAL) PINK