IREDELL COUNTY HEALTH DEPARTMENT

Statesville Office (704) 878-5305 Mooresville Office (704) 660-3625 PERMIT # 215308

IMPROVEMENT PERMIT / AUTHORIZATION TO CONSTRUCT / OPERATION PERMIT / EXISTING SYSTEM

PIN # 4701980632

APPLICANT: Gerald Rimmer APPLICANT ADDRESS: P.O. Box 582 Troutman NC

SITE ADDRESS: 116 Lake top Ln Statesville NC PHONE: 704-902-1080 ALT. PHONE: 980-939-4062

SITE DIRECTIONS: Buffalo Shoals T/R Eutola Rd T/L Carriage T/R Lake top Lot on right


SUBDIVISION: Top of the Lake SECTION: N/A LOT # 4 LOT AREA: .650 ac DESIGN FLOW: Ex L.T.A.R.: Ex

Septic Tank	Ex	(gal)	STB		Date		☐ New System	☐ Repair	☐ Expansion	System Type: I	☒ II	III IV V VI	☒ Residence	No. Bedrooms	Ex	Water Supply	
Pump Tank		(gal)	PT		Date		System Description:	Existing					☐ Business	No. Persons	Ex	☒ Private	
Pump Make		Model			Serial #		Repair System Description:						☐ Other	No. Employees		☐ Public	
# Nitrification Fields	Ex	# Lines	Ex		Linear Ft:	Ex	Maintenance Agreement Required:	☐ YES	☒ NO				☐ Slab	☒ Crawl Space		☐ Community	
Trench Width	Ex	Max. Trench Bottom Depth		Ex	Gravel Depth	Ex		☒ GRAVITY	☐ PRESSURE				☐ Basement w/ plumbing		☐ Basement w/o plumbing		

Comments / Conditions: All building foundations must be 35' from any part of STS and 25' from any well.

INITIAL SITE SKETCH

AS BUILT SKETCH

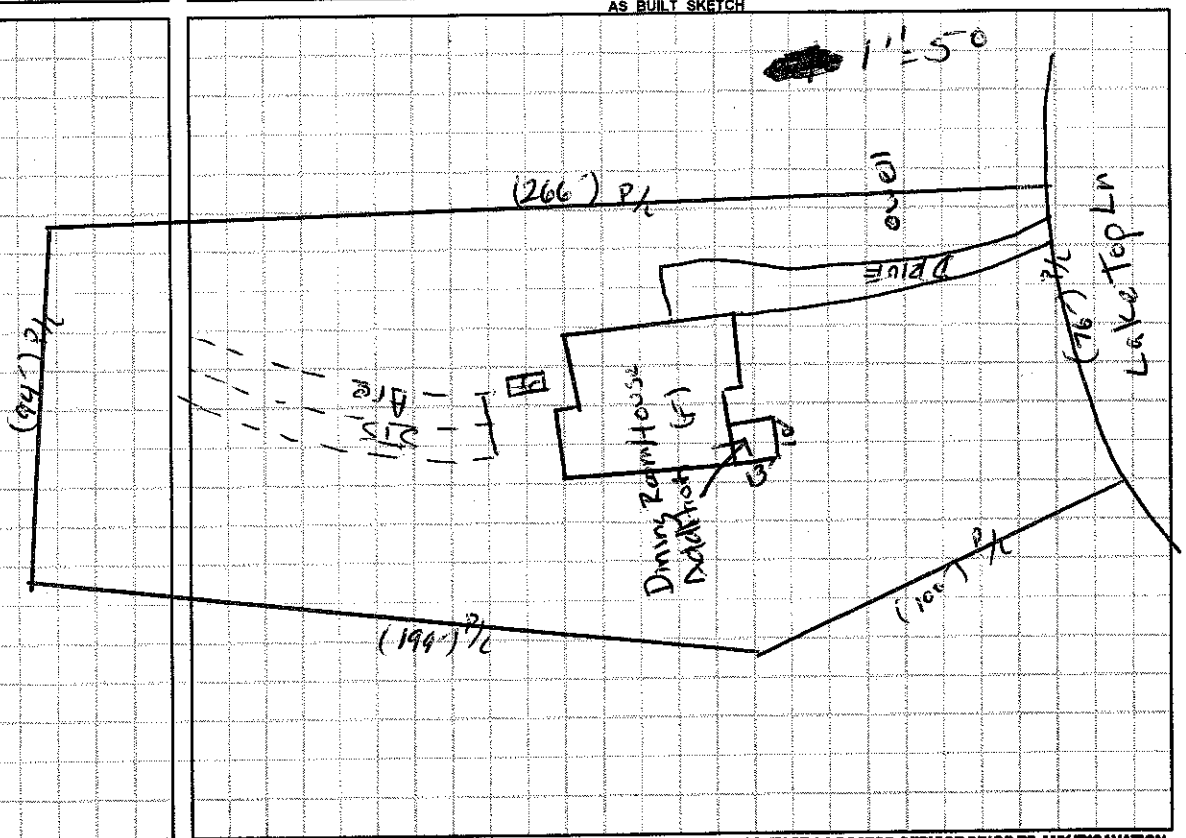

Permit can be suspended or revoked if any false information is supplied toward securing the permit / any unauthorized changes are made to the site / any unauthorized changes are made in the installation of the system. **CONTACT A LOCATOR SERVICE PRIOR TO ANY EXCAVATION**

☐ **IMPROVEMENT PERMIT** *with plat valid without expiration.* ☐ **IMPROVEMENT PERMIT** *with site plan valid for 60 mos.* ☐ **AUTHORIZATION TO CONSTRUCT** *valid for period equal to IMPROVEMENT PERMIT--not to exceed 60 mo.*

Owner / Applicant Signature: Gerald Rimmer Date: 1-13-15 Installed by:

IMPROVEMENT PERMIT by: Date: OPERATION PERMIT by: Date:

AUTHORIZATION TO CONSTRUCT by: Date: Existing System Inspected by: David H Lee Date: 01/06/16

Health Dept. Copy - WHITE Applicant (Final Approval) - YELLOW Applicant (Conditional Approval) - PINK