# IREDELL COUNTY HEALTH DEPARTMENT

STATESVILLE 704-878-5305 MOORESVILLE 704-664-5281

## IMPROVEMENT PERMIT / AUTHORIZATION TO CONSTRUCT / OPERATION PERMIT / EXISTING SYSTEM INSPECTION

PERMIT# PIN# DATE 12-16-98

OWNER OR CONTRACTOR Jerry Rogers PHONE: Business Home 528 4134

ADDRESS 405 Carriage Ln

LOCATION Enfola Rd Turn carriage Ln on left before end.

SUBDIVISION BLOCK / SECTION LOT LOT AREA SITE CLASS DESIGN FLOW L.T.A.R. .13

Septic Tank: Ex. Gallons: STB Date

Pump Tank: Gallons: PT Date

Pump Make: Model Serial No

Nitrification Field: No Fields 1 Square Feet 780 Linear Feet 260

No Lines 2 Trench Width 36" Max Trench Bottom Depth 36" + Gravel Depth 18"

☐ New System ☑ Repair System Type: I (II) III, IV, V, VI

System Description:

Repair System Description: Conv. Gravity

Maintenance Agreement Required: ☐ Yes ☑ No

☐ House/Mod. Home ☑ Mobile Home ☐ Business ☐ Other


No. Bedrooms 3 No. Bathrooms 2 No. Employees

Water Supply: ☑ Individual ☐ Public ☐ Community

☐ Slab ☐ Crawl Space ☐ Basement w/plumbing ☐ Basement wo/plumbing


Comments/Conditions: Check Tee Repair if necessary

INITIAL SITE SKETCH

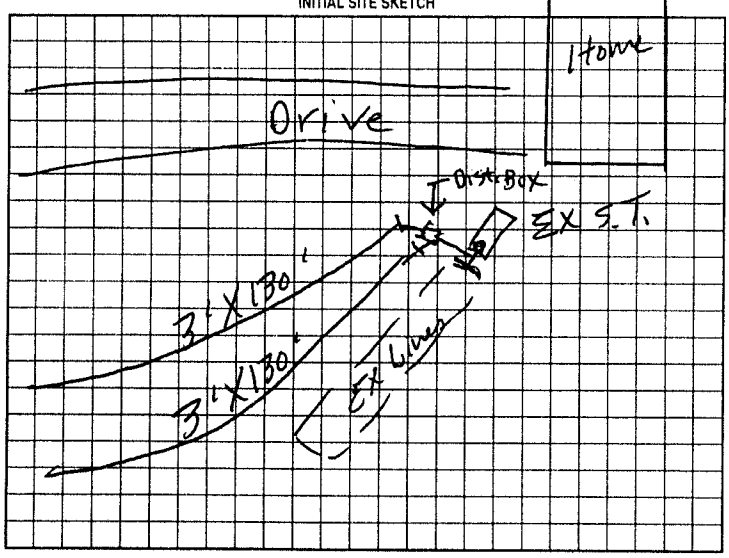


Comments/Conditions: Tee was OK New Dist. Box set In Front of S.T. with new lines from tee into new box

AS BUILT SKETCH

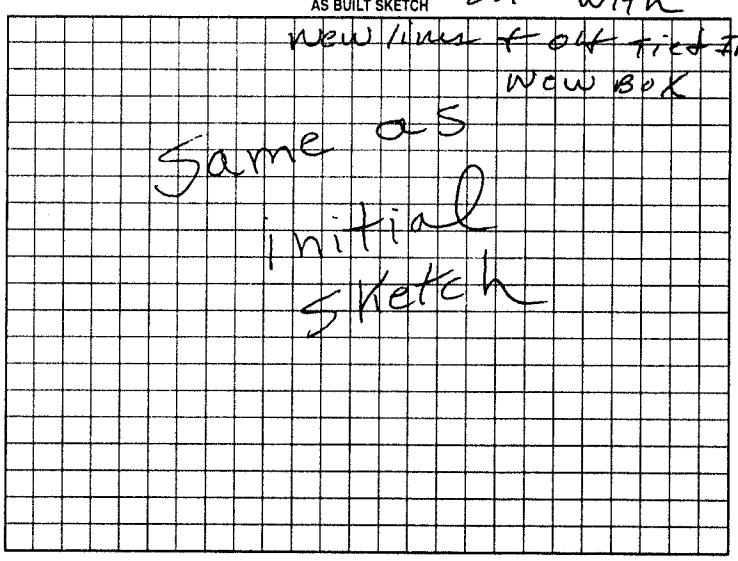


Permit can be suspended or revoked if any false information is supplied toward securing the permit/any unauthorized changes are made to the site/any unauthorized changes are made in the installation of the system. Improvement Permit with plat valid without expiration. Improvement Permit with site plan valid for sixty months. Authorization to Construct is valid for a period equal to that of Improvement Permit – not to exceed sixty months.

Signed: X Billy D. Sigmon (Agent) date Installed by: Barry Sigmon

Improvement Permit by: L. C. Moore date 12-16-98 Operation Permit by: L. C. Moore date 1-13-99

Authorization to Construct by: L. C. Moore date 12-16-98 Existing System Inspection by: date

HEALTH DEPT COPY WHITE OWNER COPY (FINAL) YELLOW OWNER COPY (INITIAL) PINK