IREDELL COUNTY HEALTH DEPARTMENT

STATESVILLE 704-878-5305 MOORESVILLE 704-664-5281

IMPROVEMENT PERMIT / AUTHORIZATION TO CONSTRUCT / OPERATION PERMIT / EXISTING SYSTEM INSPECTION

PERMIT# 089069 PIN# 4701983690 DATE May 16, 2000

OWNER OR CONTRACTOR Rogers Printing Co. (Linda Tamez) PHONE: Business 528-4134 Home

ADDRESS 405 Carriage Dr. Statesville

LOCATION Old NC 90 Rd. from Trantman TL Buffalo Shoals TR Eufola TL Carriage on Right @ jct w/ Lake Top Lane

SUBDIVISION Top of the Lake BLOCK / SECTION LOT 1 LOT AREA .99 SITE CLASS PS DESIGN FLOW 360gpd L.T.A.R. .3+

Septic Tank: 1000 Gallons; STB 1012 Date 8-25-00

Pump Tank: Gallons; PT Date

Pump Make: Model Serial No.

Nitrification Field: No Fields 1 Square Feet 900 Linear Feet 300

No Lines 3 Trench Width 36" Max Trench Bottom Depth 36"

☑ New System ☐ Repair System Type: I, II, III, IV, V, VI

System Description: Gravity Innovative-25% Reduction

Repair System Description: Lt Gravel Bark

Maintenance Agreement Required: ☐ Yes ☑ No

Gravel Depth N/A ☐ Slab ☑ Crawl Space ☐ Basement w/plumbing ☐ Basement wo/plumbing

☑ House/Mod. Home No. Bedrooms 3

☐ Mobile Home No. Bathrooms 2

☐ Business No. Employees


☐ Other

Water Supply: ☑ Individual ☐ Public ☐ Community


Comments:/Conditions: ① ONE INSPECTION PORT PER LATERAL, SET Flush w/ finished grade. ok to use either Drop Boxes or A single D Box w/ Levelers.

Comments:/Conditions:

1"=50' INITIAL SITE SKETCH

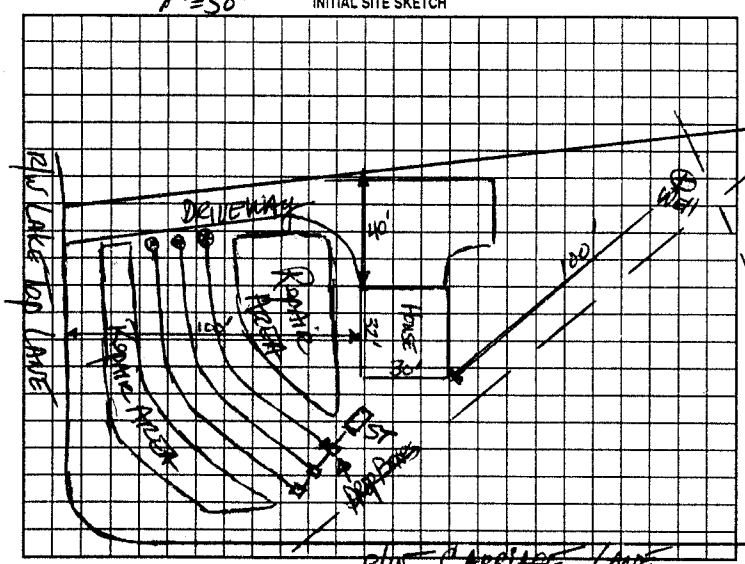

AS BUILT SKETCH

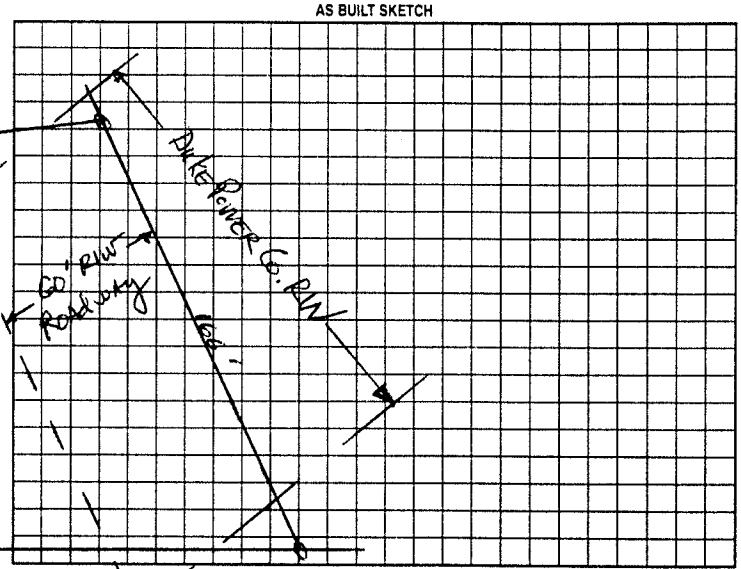

Permit can be suspended or revoked if any false information is supplied toward securing the permit/any unauthorized changes are made to the site/any unauthorized changes are made in the installation of the system. Improvement Permit with plat valid without expiration. Improvement Permit with site plan valid for sixty months. Authorization to Construct is valid for a period equal to that of Improvement Permit – not to exceed sixty months.

Signed: Debbie Rogers date 5-2-00

Improvement Permit by: date 5/16/00

Authorization to Construct by: date 5-16-00

Installed by: David Young date

Operation Permit by: date 10-13-00

Existing System Inspection by: date

HEALTH DEPT. COPY: WHITE OWNER COPY (FINAL): YELLOW OWNER COPY (INITIAL): PINK