IREDELL COUNTY HEALTH DEPARTMENT

STATESVILLE 704-878-5305 MOORESVILLE 704-664-5281

IMPROVEMENT PERMIT / CERTIFICATE OF COMPLETION / OPERATION PERMIT / EXISTING SYSTEM INSPECTION

PROPERTY DESCRIPTION NO. 065834 DATE 4-18-97 TAX MAP NO. 4701983093 Watershed: ☐ Yes ☐ No WSIV CA

OWNER OR CONTRACTOR Evelyn Rogers PHONE: Business Home 704-528-4134

ADDRESS 405 Carriage Rd

LOCATION Enfield Rd to Turn Carriage Rd 1/2 mi on left

SUBDIVISION BLOCK / SECTION LOT LOT AREA 3.53 acres SITE CLASS. PS DESIGN FLOW 360 L.T.A.R. 13

Septic Tank: 1000 Gallons; STB 794 Date 5-5-97

Pump Tank: Gallons; PT Date

Pump Make: Model Serial No.

Nitrification Field: No Fields 1 Square Feet 1200 Linear Feet 400

No Lines 3 Trench Width 36" Max Trench Bottom Depth 31" Gravel Depth 12"

☑ New System ☐ Repair System Type: I, II, III, IV, V, VI

System Description: Conv. Gravity

Repair System Description: " "

Maintenance Agreement Required: ☐ Yes ☑ No

☐ House/Mod. Home No. Bedrooms 3

☑ Mobile Home No. Bathrooms 2

☐ Business No. Employees

☐ Other


☐ Slab ☑ Crawl Space ☐ Basement w/plumbing ☐ Basement wo/plumbing

Water Supply: ☑ Individual ☐ Community ☐ Public


Comments:

Comments: Installed as shown

INITIAL SITE SKETCH

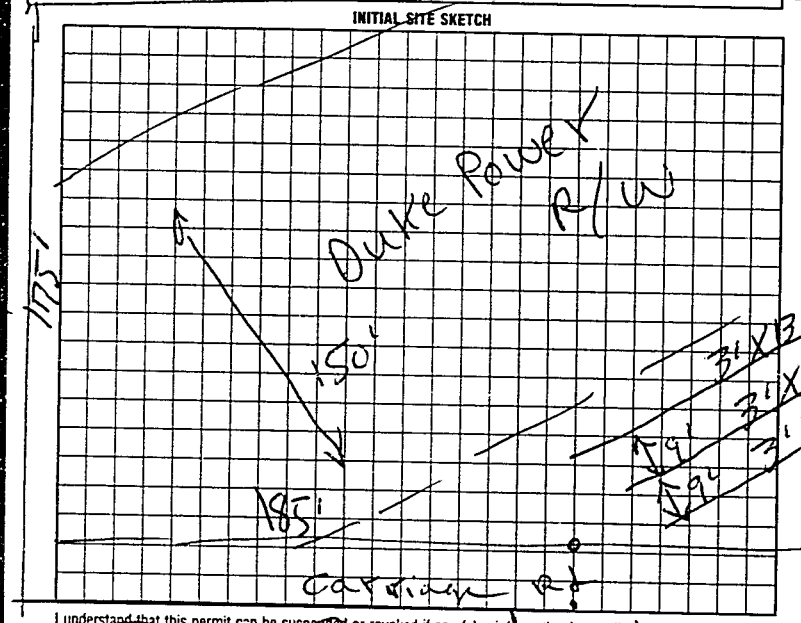

AS BUILT SKETCH

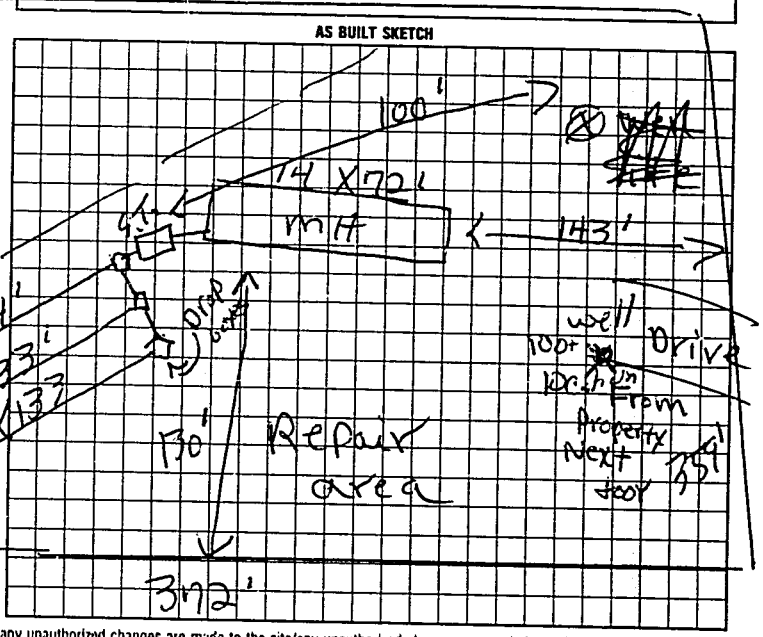

I understand that this permit can be suspended or revoked if any false information is supplied toward securing the permit/any unauthorized changes are made to the site/any unauthorized changes are made in the installation of the system. Improvement Permit is valid for 60 months from date of issuance.

Signed: Berry Rogers

Improvement Permit by: P.C. Moore date 4-18-97

Authorization to Construct by: P.C. Moore date 4-18-97

Installed by: Berry Sigmon

Certificate of Completion by: date

Operation Permit by: Mat C OA RS date 6-5-97

HEALTH DEPT COPY WHITE INSPECTION COPY (FINAL) GREEN OWNER COPY (FINAL) YELLOW INSPECTION COPY (INITIAL) PINK OWNER COPY (INITIAL) GOLD

Authorization to Construct Expires 60 months from issue