IREDELL COUNTY HEALTH DEPARTMENT

STATESVILLE 704-878-5305 MOORESVILLE 704-664-5281

IMPROVEMENT PERMIT / AUTHORIZATION TO CONSTRUCT / OPERATION PERMIT / EXISTING SYSTEM INSPECTION

PERMIT # 159604 PIN # 4702057[illegible]331 DATE 1-21-10

OWNER or APPLICANT Glenn & Teresa Sigmon (Clayton MH) PHONE: Business 704 873 2547 Home:

OWNER or APPLICANT ADDRESS 404 Eufola Rd.

LOCATION / DIRECTIONS 40 W, (L) on Old Mtn, (R) on E. Lewis Ferry, (R) Eufola, Lot 1 mile on left - 1923 Leland Ford Road

SUBDIVISION n/a BLOCK / SECTION n/a LOT # n/a LOT AREA 1.8 Ac. DESIGN FLOW 360 L.T.A.R. Ex


Septic Tank	Ex	Gallons: STB	Ex	Date	Ex	☐ New System	☐ Repair	☐ Expansion System	Type I II III IV V VI	☒ Residence	No. Bedrooms 3	Water Supply
Pump Tank		Gallons: P.T		Date		System Description: Ex				☐ Business	No. Persons	☒ Private
Pump Make		Model		Serial #		Repair System Description: Ex				☐ Other	No. Employees	☐ Public
Nitrification Field	No Fields Ex	No Lines Ex	Linear Feet Ex			Maintenance Agreement Required	☐ YES	☒ NO		☐ Slab	☒ Crawl Space	☐ Community
Trench Width	Ex	Max. Trench Bottom Depth	Ex	Gravel Depth	Ex	☒ GRAVITY	☐ PRESSURE			☐ Basement w/plumbing	☐ Basement w/o plumbing	

Comments / Conditions


Comments / Conditions

1" = 50'

INITIAL SITE SKETCH

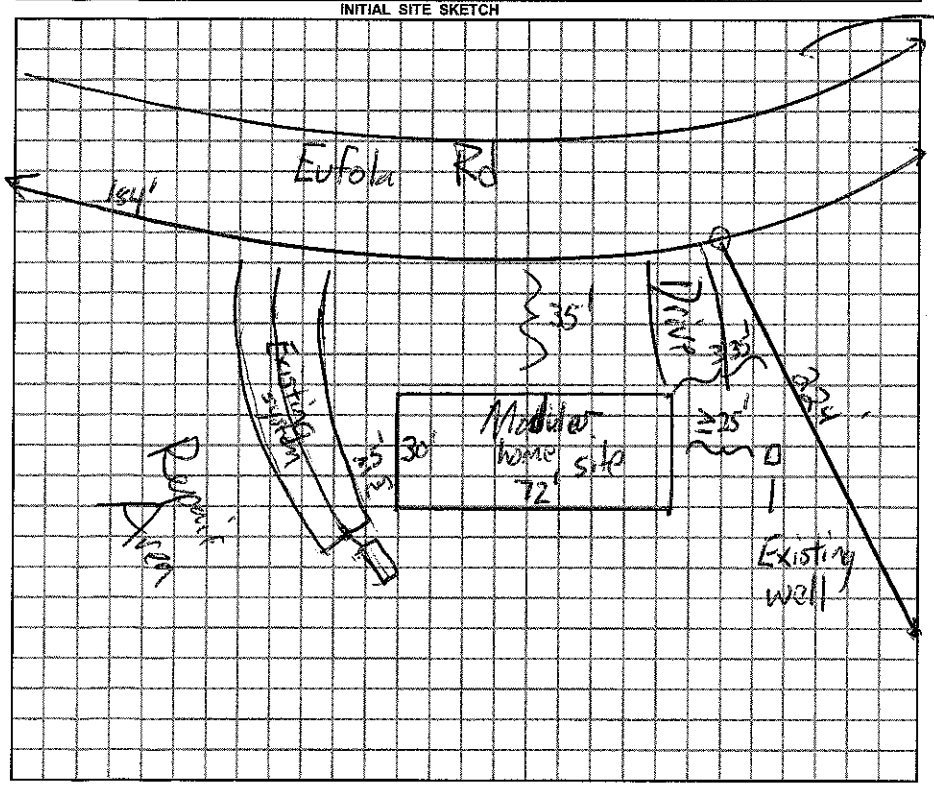

AS BUILT SKETCH

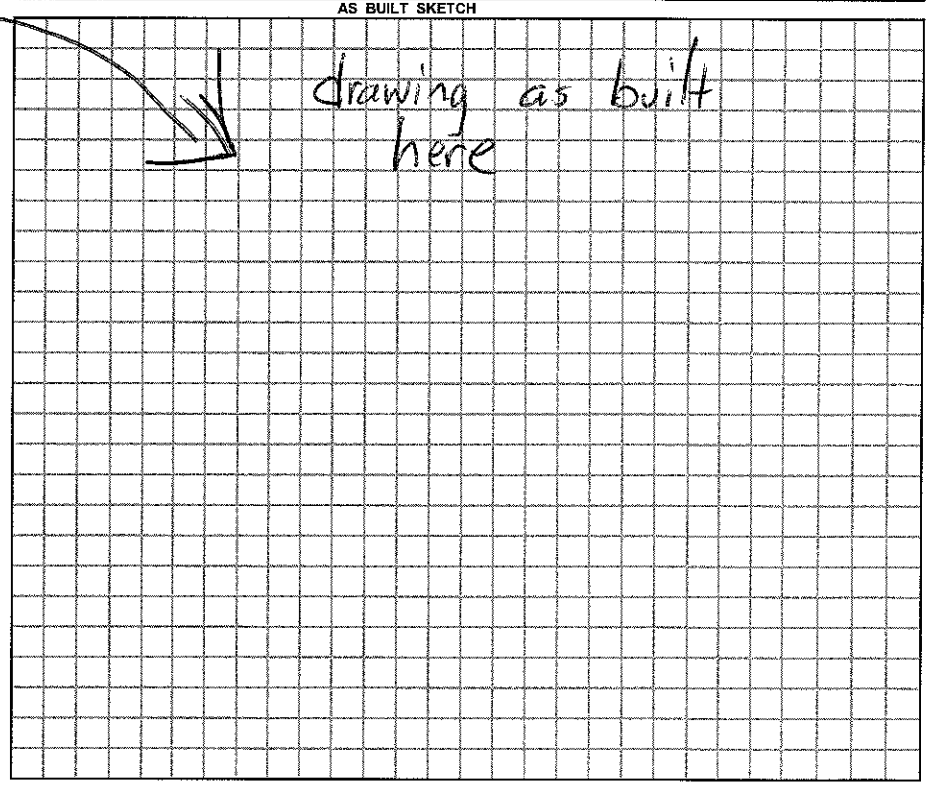

Permit can be suspended or revoked if any false information is supplied toward securing the permit / any unauthorized changes are made to the site / any unauthorized changes are made in the installation of the system.

☐ *IMPROVEMENT PERMIT w / plat valid without expiration* ☒ *IMPROVEMENT PERMIT w / site plan valid for 60 mos.* ☒ *AUTHORIZATION TO CONSTRUCT valid for period equal to IMPROVEMENT PERMIT-not to exceed 60 mo.*

Owner / Applicant Signature: [signature] Date 1/21/10

Improvement Permit by: Date

Authorization to Construct by: Date

YOU SHOULD CONTACT A LOCATOR SERVICE PRIOR TO ANY EXCAVATION.

Installed by:

Operation Permit by: Date:

Existing System Inspected by: [signature] Date: 1-21-10

WHITE COPY Environmental Health YELLOW COPY (Final) Owner / Applicant PINK COPY (Initial) Owner / Applicant