IREDELL COUNTY HEALTH DEPARTMENT - *ENVIRONMENTAL HEALTH* ☐ STATESVILLE OFFICE 704-878-5305 ☐ MOORESVILLE OFFICE 704-664-5281

IMPROVEMENT PERMIT / AUTHORIZATION TO CONSTRUCT / OPERATION PERMIT / EXISTING SYSTEM INSPECTION

PERMIT # REPAIR PIN # 4702-05-8495 DATE MAY 11, 2011

OWNER LOY ALAN HOKE APPLICANT: SAME PHONE: Home/Cell # 704-585-9876 Business # 704-880-0738

SITE ADDRESS 414 EUFOLA ROAD, STATESVILLE OWNER / APPLICANT ADDRESS 362 BOLICK ROAD, STONY POINT, NC 28678

SITE DIRECTIONS ~~BLACK~~ OLD MOUNTAIN ROAD, TO LEWIS FERRY ROAD, TR EUFOLA ROAD, 1.1 MILES ON LEFT AT #414


SUBDIVISION BLOCK / SECTION LOT # LOT AREA 1.187 ACRES DESIGN FLOW 360 L.T.A.R. 0.25 GPD/FT²

Septic Tank EXISTING	Gallons: STB	Date	☐ New System	☑ Repair	☐ Expansion System	Type I II (III) IV V VI	☑ Residence	No. Bedrooms 3	Water Supply
Pump Tank	Gallons: P T	Date	System Description:				☐ Business	No. Persons	☑ Private WELL
Pump Make	Model	Serial #	Repair System Description: 25% REDUCTION, GRAVITY				☐ Other	No. Employees	☐ Public
No. Nitrification Fields: 1	No. Lines 3	Linear Feet 240	Maintenance Agreement Required ☐ YES ☑ NO				☐ Slab	☑ Crawl Space	☐ Community
Trench Width 36"	Max. Trench Bottom Depth 30"	Gravel Depth N/A	☑ GRAVITY ☐ PRESSURE				☐ Basement w/plumbing	☐ Basement w/o plumbing	


Comments / Conditions (1) INTERCEPT EXISTING DRAINLINES USING TWO NEW DROP BOXES AT LOCATION SHOWN (2) SERIAL FEED NEW 25% REDUCTION DRAINLINES, INSTALLED ON CONTOUR AS FLAGGED, NO DEEPER THAN 30 INCHES.

SEE ATTACHED N.O.V.

INITIAL SITE SKETCH

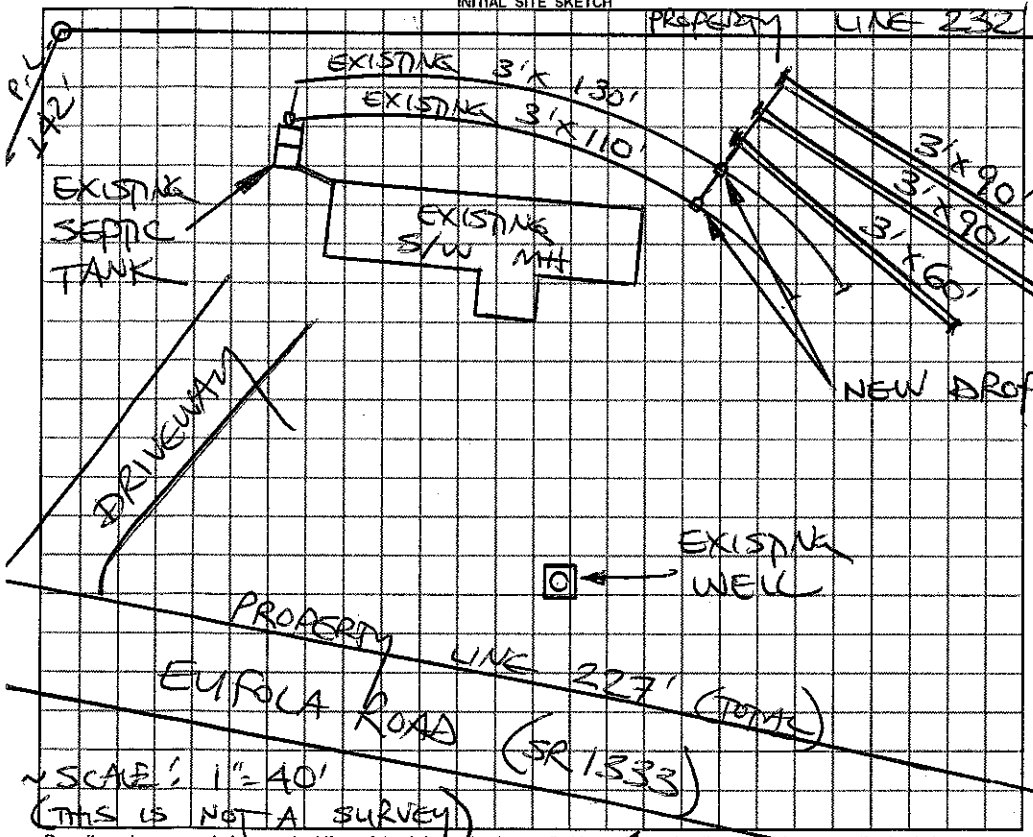

AS BUILT SKETCH

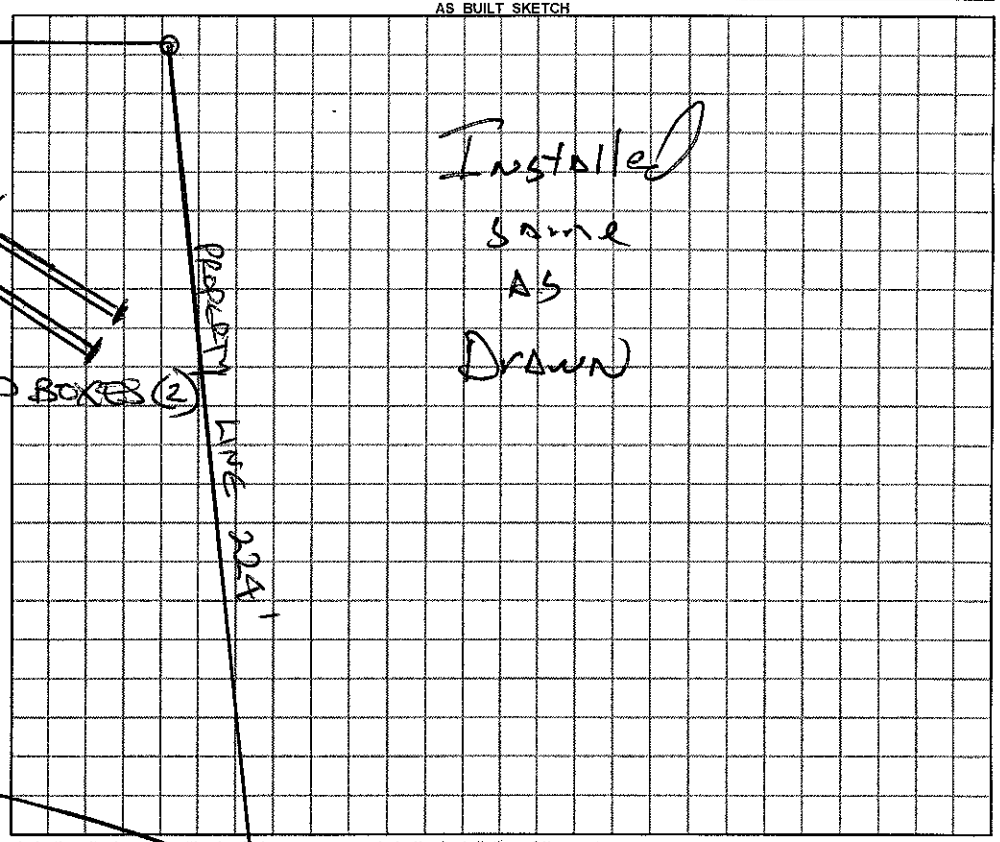

Permit can be suspended or revoked if any false information is supplied toward securing the permit / any unauthorized changes are made to the site / any unauthorized changes are made in the installation of the system.

☐ ***IMPROVEMENT PERMIT*** with plat valid without expiration. ☑ ***IMPROVEMENT PERMIT*** with plat valid without expiration. site plan valid 60 mo. ☑ ***AUTHORIZATION TO CONSTRUCT*** valid for period equal to IMPROVEMENT PERMIT--not to exceed 60 mo.

Owner / Applicant Signature: LOY HOKE Date 5/12/2011 Installed by: James H. Miller

IMPROVEMENT PERMIT by: STEVE HEDRICK REHS Date 5/11/2011 OPERATION PERMIT by: REHS Date June 1

AUTHORIZATION TO CONSTRUCT by: STEVE HEDRICK REHS Date 5/11/2011 Existing System Inspected by: REHS Date

YOU SHOULD CONTACT A LOCATOR SERVICE PRIOR TO ANY EXCAVATION

White Copy – Environmental Health YELLOW COPY (Final) Owner / Applicant PINK COPY (initial) Owner / Applicant