*THIS PERMIT VOIDS PREVIOUS PERMIT, ISSUED 7-29-02.

IREDELL COUNTY HEALTH DEPARTMENT

STATESVILLE 704-878-5305 (c) MOORESVILLE 704-664-5281

IMPROVEMENT PERMIT / AUTHORIZATION TO CONSTRUCT / OPERATION PERMIT / EXISTING SYSTEM INSPECTION

PERMIT# 106608 PIN# 4702-28-5377 DATE 06/06/03

OWNER OR CONTRACTOR JENKINS & WILLIAMS Construction PHONE: Business 704-872-0922 Home

ADDRESS 132 MODULAR LN, STATESVILLE, NC 28625

LOCATION I-40 WEST, (L) Old Mtn. Rd., (R) LEWIS FERRY, (R) EUFOLA, (R) BROAD MEADOW, ~0.3 MILES ON LEFT, JUST BEFORE CURVE.

SUBDIVISION BROAD MEADOWS BLOCK / SECTION 4 LOT 30 LOT AREA 0.915 ACRES SITE CLASS. PS DESIGN FLOW 360GPD L.T.A.R. 0.30 GPD/FT²

Septic Tank: 1,000 Gallons; STB 1007 Date 5-28-03
Pump Tank: ____ Gallons; PT ____ Date ____
Pump Make: ____ Model ____ Serial No. ____
Nitrification Field: No Fields 1 Square Feet EQ to 1,200 Linear Feet 300
No Lines 6 Trench Width 36" Max Trench Bottom Depth 36" Gravel Depth N/A

(X) New System ☐ Repair System Type: I, II, (III), IV, V, VI
System Description: 25% REDUCTION, GRAVITY
Repair System Description: PUMP, 25% REDUCTION
Maintenance Agreement Required: ☐ Yes (X) No


☐ House/Mod. Home No. Bedrooms 3
(X) Mobile Home No. Bathrooms 2
☐ Business No. Employees ____
☐ Other ____

☐ Slab (X) Crawl Space ☐ Basement w/plumbing ☐ Basement wo/plumbing

Water Supply: ☐ Individual (X) Public ☐ Community


Comments:/Conditions:

INITIAL SITE SKETCH

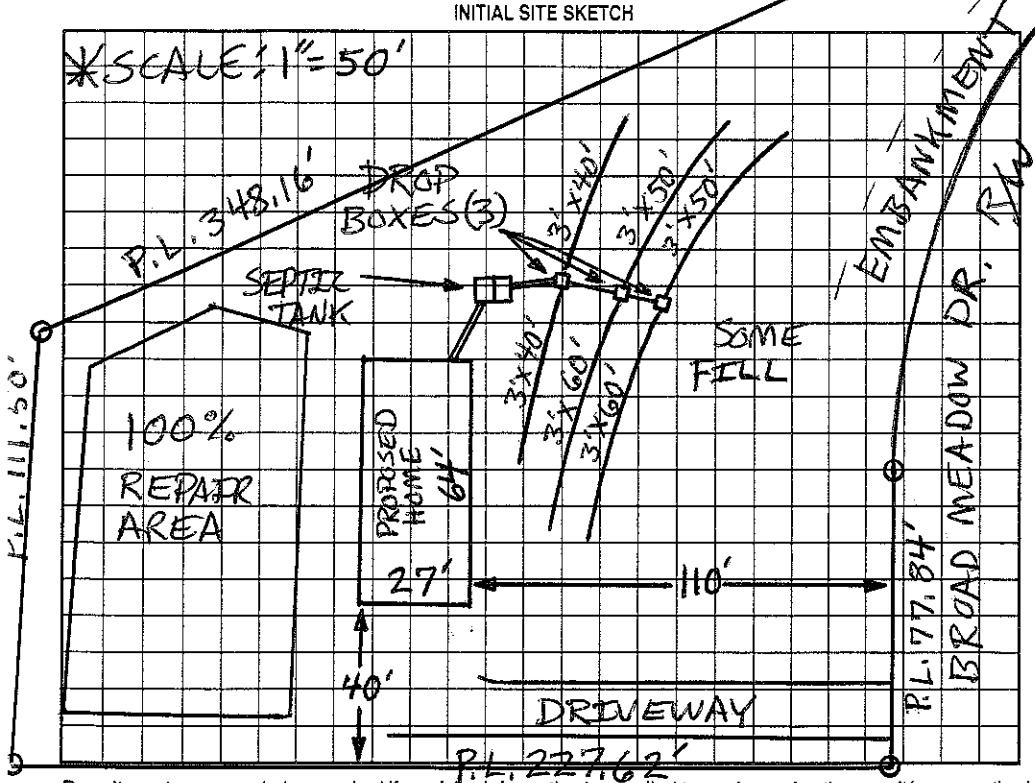

Comments:/Conditions:
(1) SEPTIC TANK WITH MARKER INSTALLED USING "POLYLOK" FILTER
(2) SYSTEM ALTERED AS SHOWN BELOW WITHOUT PRIOR HEALTH DEPARTMENT APPROVAL

AS BUILT SKETCH

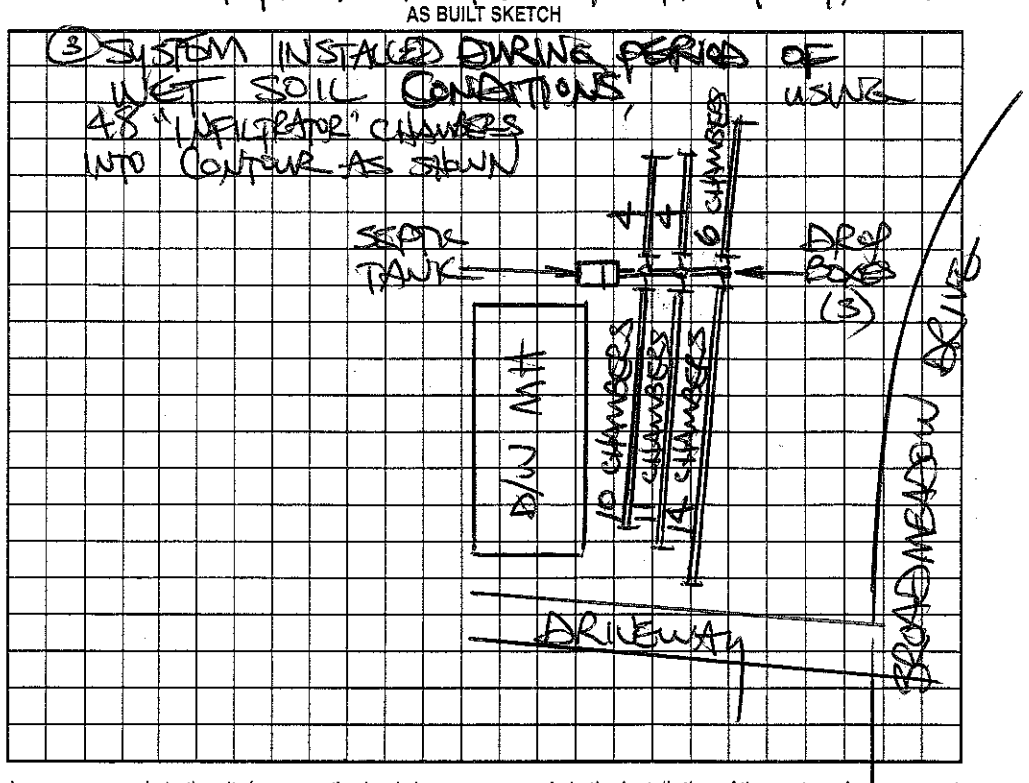

Permit can be suspended or revoked if any false information is supplied toward securing the permit/any unauthorized changes are made to the site/any unauthorized changes are made in the installation of the system. Improvement Permit with plat valid without expiration. Improvement Permit with site plan valid for sixty months. Authorization to Construct is valid for a period equal to that of Improvement Permit – not to exceed sixty months.

Signed: [signature] date 7/2/03 Installed by: TOMMY COTHREN

Improvement Permit by: Patrick Mitchell date 06/06/03 Operation Permit by: STEVE HENDRICK date 7-30-03

Authorization to Construct by: Patrick Mitchell date 06/06/03 Existing System Inspection by: ____ date ____

HEALTH DEPT. COPY: WHITE OWNER COPY (FINAL): YELLOW OWNER COPY (INITIAL): PINK