IREDELL COUNTY HEALTH DEPARTMENT

STATESVILLE 704-878-5305 MOORESVILLE 704-664-5281

IMPROVEMENT PERMIT / AUTHORIZATION TO CONSTRUCT / OPERATION PERMIT / EXISTING SYSTEM INSPECTION

PERMIT# 095204 PIN# 4702 29 6306 DATE 3/17/01

OWNER OR CONTRACTOR SUNWOOD BUILDERS PHONE: Business (704) 872-0922 Home

ADDRESS P.O. Box 5877 STATESVILLE, NC 28687

LOCATION 70 W (L) OLD MTN. RD. (R) LEWIS FERRY (R) EUFOLA (R) BROADMEADOW ON (L)

SUBDIVISION BROAD MEADOW BLOCK / SECTION LOT 27 LOT AREA .57 Ac. SITE CLASS PS DESIGN FLOW 360 GPD L.T.A.R. .3

Septic Tank: 1000 Gallons: STB 1012 Date 3-17-01
Pump Tank: Gallons: PT Date
Pump Make: Model Serial No.
Nitrification Field: No Fields 1 Square Feet 300 Linear Feet 300'
No Lines 4 Trench Width 3' Max Trench Bottom Depth 30"

☑ New System ☐ Repair System Type: I, II, III, IV, V, VI
System Description: 25% REDUCTION
Repair System Description: SAME
Maintenance Agreement Required: ☐ Yes ☑ No
Gravel Depth N/A ☐ Slab ☑ Crawl Space ☐ Basement w/plumbing ☐ Basement wo/plumbing


☐ House/Mod. Home No. Bedrooms 3
☑ Mobile Home No. Bathrooms 2
☐ Business No. Employees
☐ Other

Water Supply: ☐ Individual ☑ Public ☐ Community


Comments/Conditions: (1) NO CUTTING OR FELLING OVER DRAINFIELD/REPAIR AREAS (2) KEEP ALL DRAINS AWAY FROM DRAINFIELD/REPAIR AREAS (3) MAINTAIN NOTED SETBACKS (4) INSTALL DRAINLINES UNIFORM AND ON CONTOUR

Comments/Conditions: POLYLOK FILTER & MARKER INSTALLED AS SHOWN BELOW

INITIAL SITE SKETCH

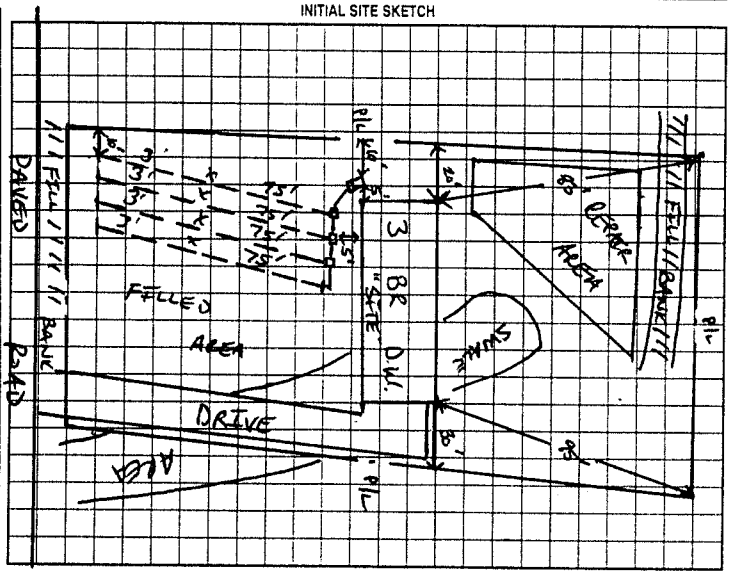

AS BUILT SKETCH

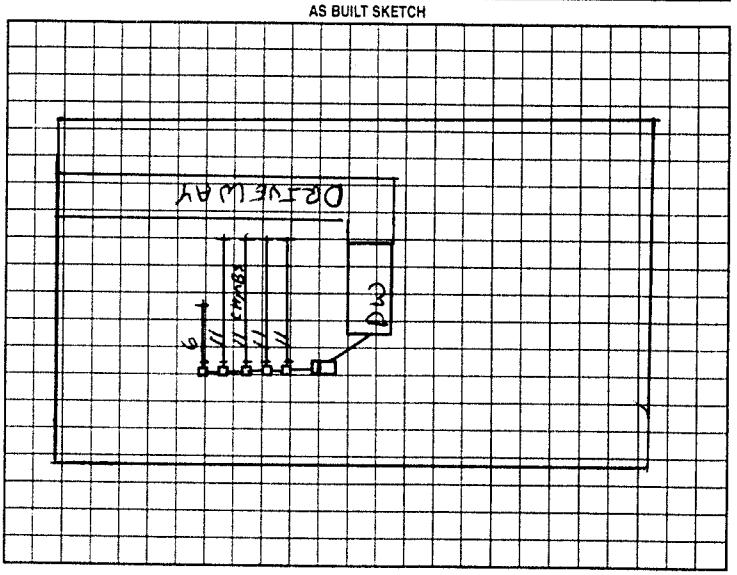

Permit can be suspended or revoked if any false information is supplied toward securing the permit/any unauthorized changes are made to the site/any unauthorized changes are made in the installation of the system. Improvement Permit with plat valid without expiration. Improvement Permit with site plan valid for sixty months. Authorization to Construct is valid for a period equal to that of Improvement Permit - not to exceed sixty months.

Signed: [signature] date 9/4/01 Installed by: TOMMY COTHREN

Improvement Permit by: [signature] date 3/17/01 Operation Permit by: [signature] RS date 8-1-01

Authorization to Construct by: [signature] date 3/17/01 Existing System Inspection by: date

HEALTH DEPT COPY WHITE OWNER COPY (FINAL) YELLOW OWNER COPY (INITIAL) PINK