IREDELL COUNTY HEALTH DEPARTMENT

STATESVILLE 704-878-5305 (CI) MOORESVILLE 704-664-5281

IMPROVEMENT PERMIT / AUTHORIZATION TO CONSTRUCT / OPERATION PERMIT / EXISTING SYSTEM INSPECTION

(5)

PERMIT# 105060 PIN# 4702-28-8518 DATE 3-15-02

OWNER OR CONTRACTOR WAYNE C. JENKINS PHONE: Business Home 704-872-0922

ADDRESS P.O. BOX 5877, STATESVILLE, NC, 28687

LOCATION OLD MOUNTAIN ROAD TO LEWIS FERRY RD, TR EUFOLA ROAD, TR BROAD MEADOW DR, 6th on (R) PAST

SUBDIVISION BROAD MEADOW BLOCK / SECTION LOT 34 LOT AREA 0.874 Ac SITE CLASS P3 DESIGN FLOW 360 L.T.A.R. 0.35 GPD/FT²

Septic Tank: 1000 Gallons: STB 1012 Date 4-29-02

Pump Tank: Gallons: PT Date

Pump Make: Model Serial No.

Nitrification Field: No Fields 1 Square Feet 1035 Linear Feet 345

No Lines Four Trench Width 36" Max Trench Bottom Depth (30") Gravel Depth 12"

☑ New System ☐ Repair System Type: I (II) III IV V VI

System Description: CONVENTIONAL GRAVITY

Repair System Description: 25% REDUCTION, GRAVITY

Maintenance Agreement Required: ☐ Yes ☑ No

☐ House/Mod. Home ☑ Mobile Home ☐ Business ☐ Other

No. Bedrooms 3½ No. Bathrooms No. Employees

☐ Slab ☑ Crawl Space ☐ Basement w/plumbing ☐ Basement wo/plumbing


Water Supply: ☐ Individual ☑ Public ☐ Community

Comments:/Conditions:


Comments:/Conditions Tuff-Tite Filter Installed

70, 95, 90, 90 - Line Lengths Tee to bottom

INITIAL SITE SKETCH

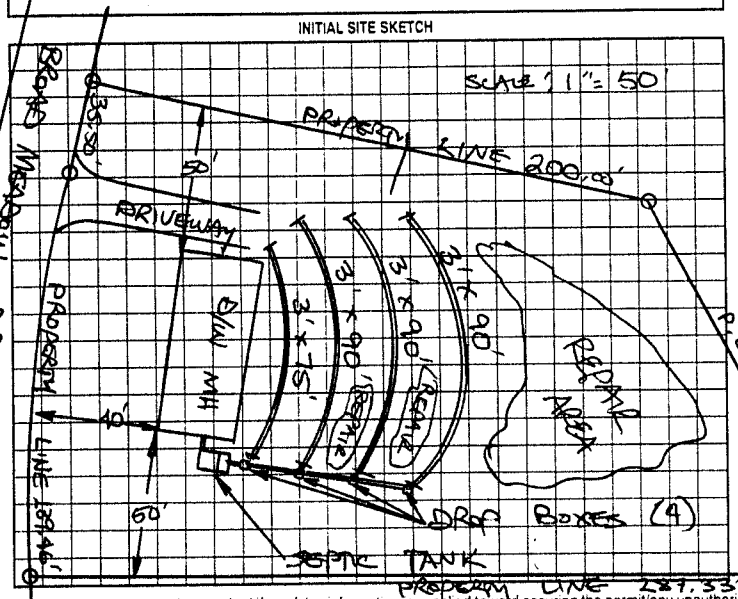

AS BUILT SKETCH

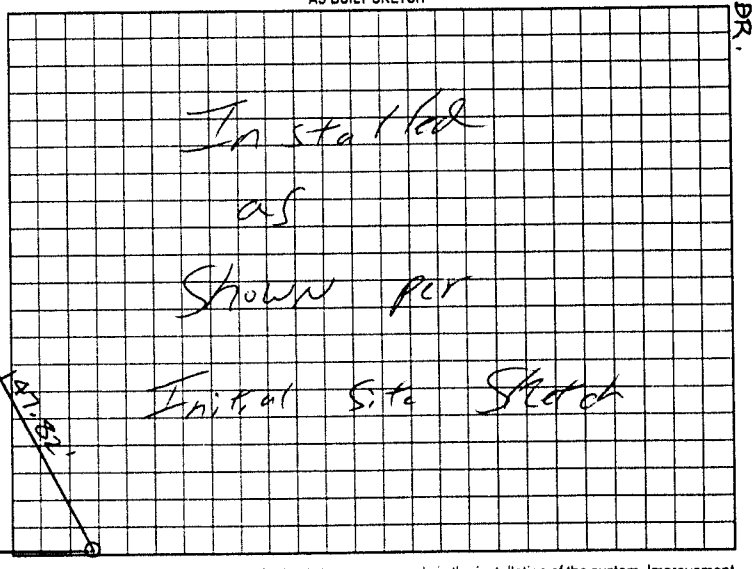

APPLE CREEK BR.

Permit can be suspended or revoked if any false information is supplied toward securing the permit/any unauthorized changes are made to the site/any unauthorized changes are made in the installation of the system. Improvement Permit with plat valid without expiration. Improvement Permit with site plan valid for sixty months. Authorization to Construct is valid for a period equal to that of Improvement Permit – not to exceed sixty months.

Signed: date 3/15/02 Installed by: Tommy Cothran

Improvement Permit by: STEVE HEDRICK date 3-15-02 Operation Permit by: date 10/9/02

Authorization to Construct by: STEVE HEDRICK date 3-15-02 Existing System Inspection by: date

HEALTH DEPT. COPY: WHITE OWNER COPY (FINAL): YELLOW OWNER COPY (INITIAL): PINK