IREDELL COUNTY HEALTH DEPARTMENT

STATESVILLE 704-878-5305 MOORESVILLE 704-664-5281

IMPROVEMENT PERMIT / AUTHORIZATION TO CONSTRUCT / OPERATION PERMIT / EXISTING SYSTEM INSPECTION

DATE 3/7/01

PERMIT# 095002 PIN# 4702 29 6306

OWNER OR CONTRACTOR SUNWOOD BUILDERS PHONE: Business (704) 872-0922 Home

ADDRESS P.O. BOX 5877, STATESVILLE, NC 28687

LOCATION 70 W (L) OLD MTN. RD. (R) LEWIS FERRY RD. (L) EUFOLA RD. (R) BROAD MEADOW DR (L)

SUBDIVISION BROAD MEADOW BLOCK / SECTION LOT 26 LOT AREA .57 Ac. SITE CLASS PS DESIGN FLOW 360 GPD L.T.A.R. .35

Septic Tank: 1000 Gallons; STB 3-6-01 Date 1012

Pump Tank: Gallons; PT Date

Pump Make: Model Serial No.

Nitrification Field: No Fields 1 Square Feet 1028 Linear Feet 342'

No Lines 5 Trench Width 3' Max Trench Bottom Depth 30" Gravel Depth 12"

☑ New System ☐ Repair System Type: I (II) III IV V VI

System Description: CONVENTIONAL

Repair System Description: 25% REDUCTION

Maintenance Agreement Required: ☐ Yes ☑ No

☐ House/Mod. Home ☑ Mobile Home ☐ Business ☐ Other

No. Bedrooms 3 No. Bathrooms 2 No. Employees


☐ Slab ☑ Crawl Space ☐ Basement w/plumbing ☐ Basement wo/plumbing

Water Supply: ☐ Individual ☑ Public ☐ Community

Comments/Conditions: (1) NO CUTTING OR FILLING OVER DRAINFIELD/REPAIR AREAS (2) KEEP ALL DRAINS AWAY FROM DRAINFIELD/REPAIR AREAS (3) MAINTAIN SETBACKS (4) INSTALL DRAINLINES UNIFORM AND ON CONTOUR.

Comments/Conditions: -Poly Lok Filter Installed -Septic Tank Riser Installed

INITIAL SITE SKETCH

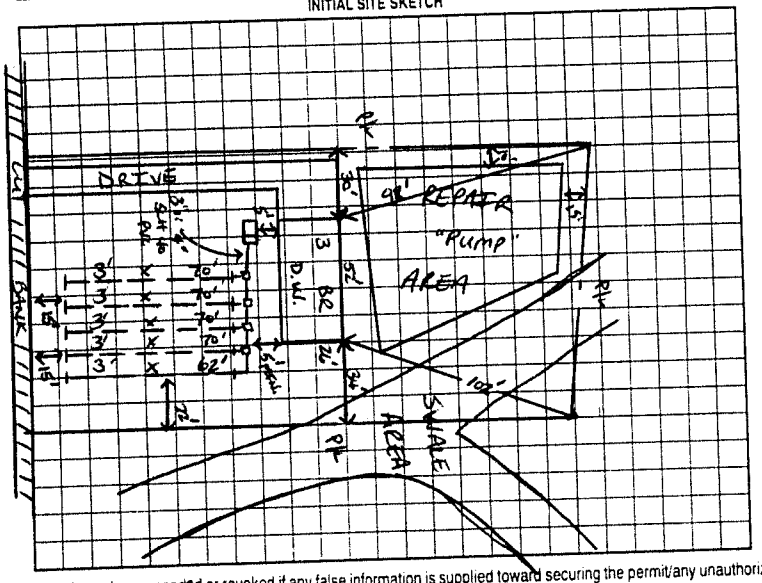

AS BUILT SKETCH

Installed as per Initial Site Sketch

Permit can be suspended or revoked if any false information is supplied toward securing the permit/any unauthorized changes are made to the site/any unauthorized changes are made in the installation of the system. Improvement Permit with plat valid without expiration. Improvement Permit with site plan valid for sixty months. Authorization to Construct is valid for a period equal to that of Improvement Permit – not to exceed sixty months.

Signed: date 3/16/01

Improvement Permit by: date 3/7/01

Authorization to Construct by: date 3/7/01

Installed by: Joey Cothern

Operation Permit by: date 6/29/01

Existing System Inspection by: date

HEALTH DEPT. COPY: WHITE OWNER COPY (FINAL): YELLOW OWNER COPY (INITIAL): PINK