IREDELL COUNTY HEALTH DEPARTMENT

STATESVILLE 704-878-5305 ✓ MOORESVILLE 704-664-5281

IMPROVEMENT PERMIT / AUTHORIZATION TO CONSTRUCT / OPERATION PERMIT / EXISTING SYSTEM INSPECTION

PERMIT# 101670 PIN# 4702-28-9569.33 DATE 8/14/01

OWNER OR CONTRACTOR Jenkins & Williams PHONE: Business 872-0922 Home

ADDRESS PO Box 5977 Statesville NC 28687

LOCATION OMR, TR E. Lewis Ferry, TR Eufola, TR Broad meadow on Rt

SUBDIVISION Broad Meadow BLOCK / SECTION LOT 33 LOT AREA SS SITE CLASS. PS DESIGN FLOW 360 L.T.A.R. 0.3

Septic Tank: 1000 Gallons; STB 1012 Date 8-14-01
Pump Tank: Gallons; PT Date
Pump Make: Model Serial No.
Nitrification Field: No. Fields 1 Square Feet 900 Linear Feet 300
No. Lines 5 @ 60' Trench Width 36" Max Trench Bottom Depth 36"

☒ New System ☐ Repair System Type: I
System Description: Gravity 25% Reduction
Repair System Description: Gravity 25% Reduc
Maintenance Agreement Required: ☐ Yes ☒ No
Gravel Depth 12" ☐ Slab ☒ Crawl Space ☐ Basement w/plumbing ☐ Basement wo/plumbing


☐ House/Mod. Home No. Bedrooms 3
☒ Mobile Home No. Bathrooms 2
☐ Business No. Employees
☐ Other

Water Supply: ☐ Individual ☒ Public ☐ Community


Comments/Conditions: Install all drain lines on Contour

Comments/Conditions: Set Fabricated Chamber System Over Rock - poly lok filter Installed

INITIAL SITE SKETCH

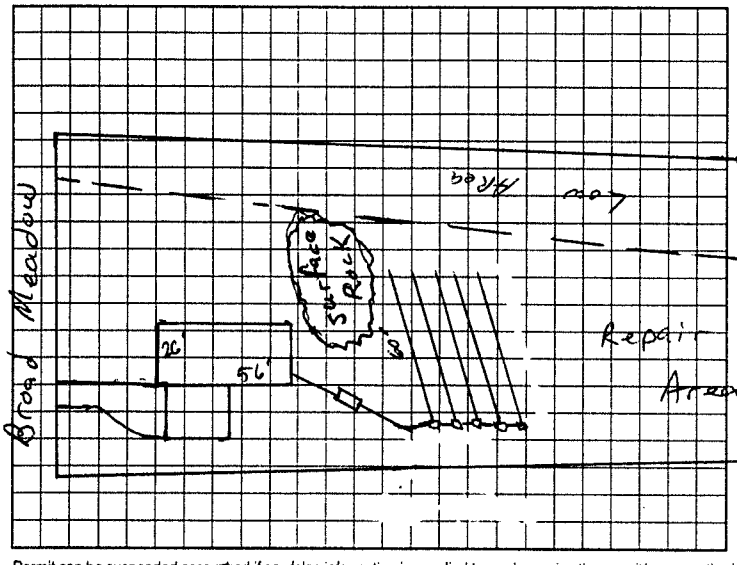

AS BUILT SKETCH

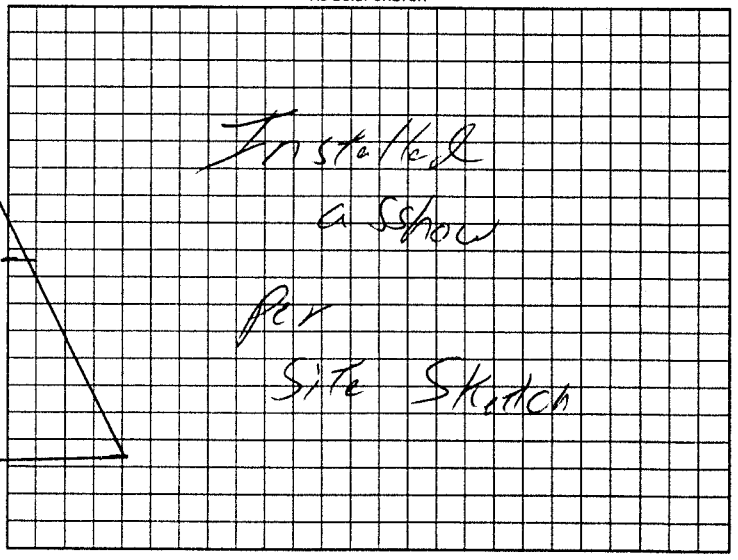

Permit can be suspended or revoked if any false information is supplied toward securing the permit/any unauthorized changes are made to the site/any unauthorized changes are made in the installation of the system. Improvement Permit with plat valid without expiration, Improvement Permit with site plan valid for sixty months. Authorization to Construct is valid for a period equal to that of Improvement Permit – not to exceed sixty months.

Signed: [signature] date 9/17/01

Improvement Permit by: [signature] RSI date 8/14/01

Authorization to Construct by: [signature] RSI date 8/14/01

Installed by: Tommy Cothran

Operation Permit by: [signature] date 1/9/02

Existing System Inspection by: date

HEALTH DEPT. COPY. WHITE OWNER COPY (FINAL). YELLOW OWNER COPY (INITIAL) PINK