IREDELL COUNTY HEALTH DEPARTMENT

STATESVILLE 704-878-5305 MOORESVILLE 704-664-5281

IMPROVEMENT PERMIT / AUTHORIZATION TO CONSTRUCT / OPERATION PERMIT / EXISTING SYSTEM INSPECTION

PERMIT# 068059 PIN# 4702 29 9046

OWNER OR CONTRACTOR Sun Wood Builders PHONE: Business 872 0121 Home DATE 2-12-98

ADDRESS PO Box 5877 Statesville NC

LOCATION 30W TL Eufola on R (L) Before Lewis Ferry

SUBDIVISION Broad Meadows BLOCK / SECTION LOT 5 LOT AREA 24941 sqft SITE CLASS P/S DESIGN FLOW 360 L.T.A.R. 0.3

Septic Tank: 1000 Gallons; STB 1012 Date 2-9-98

Pump Tank: Gallons; PT Date

Pump Make: Model Serial No.

Nitrification Field: No Fields 1 Square Feet 1700 Linear Feet 500

No Lines 5 Trench Width 36in Max Trench Bottom Depth 36in Gravel Depth 12in

☒ New System ☐ Repair System Type: I, II, III, IV, V, VI

System Description: Gravity Conventional

Repair System Description: Gravity / Pump ~~Conventional~~

Maintenance Agreement Required: ☐ Yes ☒ No panel

☐ House/Mod. Home ☒ Mobile Home ☐ Business ☐ Other

No. Bedrooms 3 No. Bathrooms 2 No. Employees


Water Supply: ☐ Individual ☒ Public ☐ Community

☐ Slab ☒ Crawl Space ☐ Basement w/plumbing ☐ Basement wo/plumbing


Comments:/Conditions: Smooth out area, Keep Lines on Contour 9ft on center

Comments:/Conditions: KNole system dropped down Tank off Back door

INITIAL SITE SKETCH

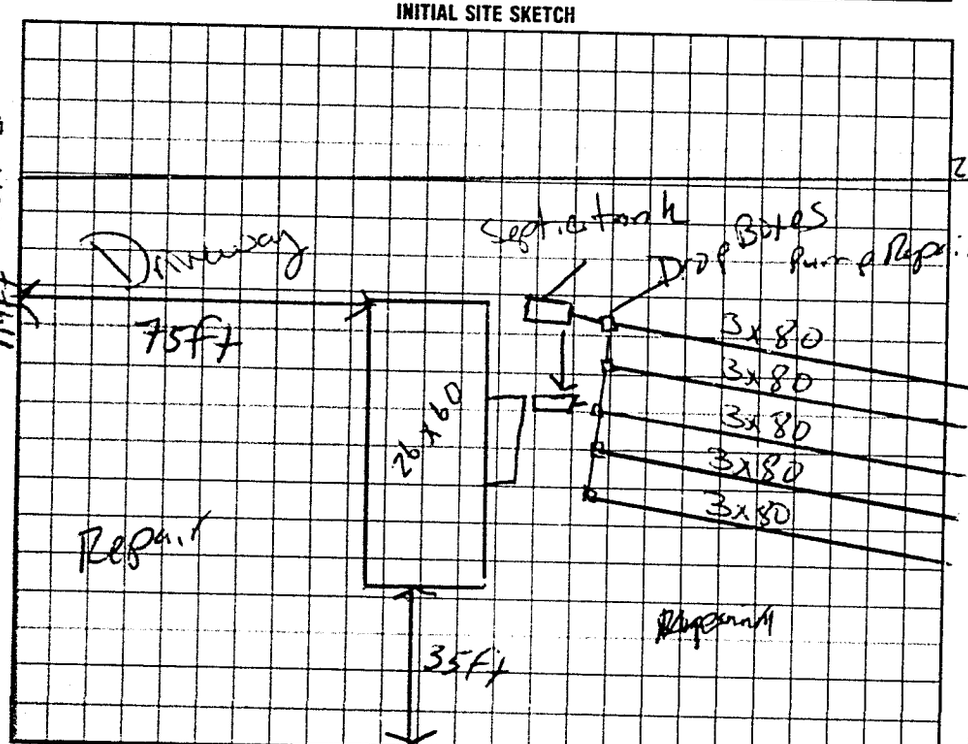

AS BUILT SKETCH

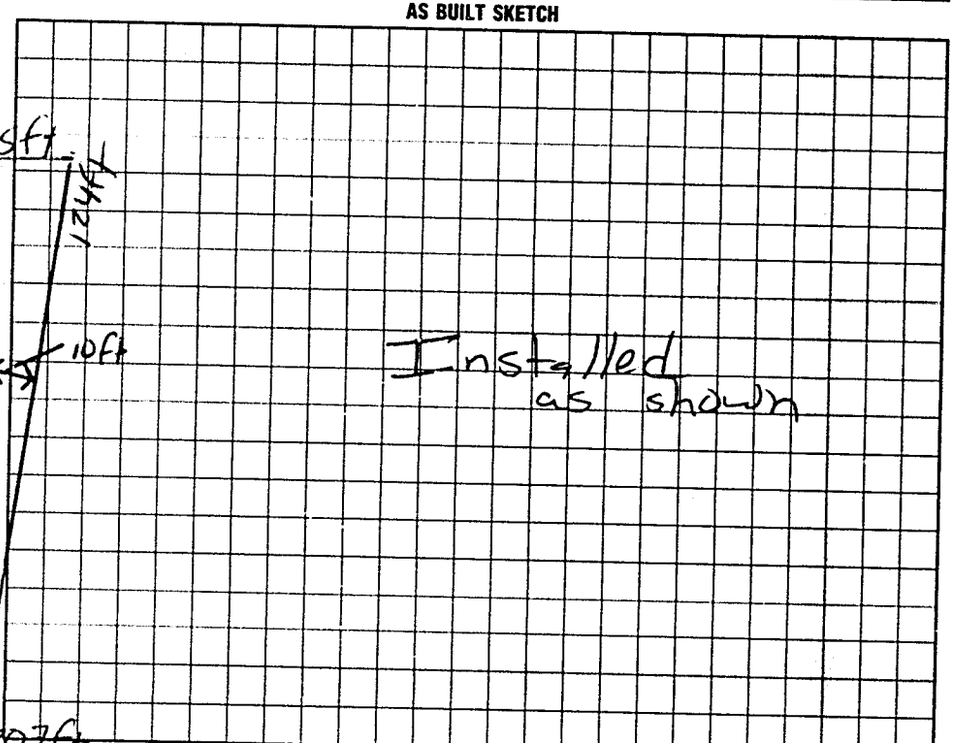

I understand that this permit can be suspended or revoked if any false information is supplied toward securing the permit/any unauthorized changes are made to the site/any unauthorized changes are made in the installation of the system. Improvement Permit with plat valid without expiration. Improvement Permit with site plan valid for sixty months. Authorization to Construct is valid for a period equal to that of Improvement Permit – not to exceed sixty months.

Signed: [signature]

Improvement Permit by: Mark C Ostrus date 2-12-98

Authorization to Construct by: Mark C Ostrus date 2-12-98

Installed by: Tommy Frye

Operation Permit by: Mark C Ostrus date 4-16-98

Existing System Inspection by: date

HEALTH DEPT. COPY WHITE INSPECTION COPY (FINAL) GREEN OWNER COPY (FINAL) YELLOW INSPECTION COPY (INITIAL) PINK OWNER COPY (INITIAL) GOLD