IREDELL COUNTY HEALTH DEPARTMENT

STATESVILLE 704-878-5305 MOORESVILLE 704-664-5281

IMPROVEMENT PERMIT / AUTHORIZATION TO CONSTRUCT / OPERATION PERMIT / EXISTING SYSTEM INSPECTION

PERMIT# 068058 PIN# 4702299046 DATE 1-6-98

OWNER OR CONTRACTOR Sunwood Builders PHONE: Business 8720921 Home

ADDRESS PO Box 5877 Statesville NC 28687

LOCATION 70W TL Eufola on Rt before Lewis Ferry Rd.

SUBDIVISION Broad Meadows BLOCK / SECTION LOT 4 LOT AREA 25049 SITE CLASS P/S DESIGN FLOW 360 L.T.A.R. 0.3

Septic Tank: 1000 Gallons; STB 1016 Date 5-7-98

Pump Tank: Gallons; PT Date

Pump Make: Model Serial No. 300

Nitrification Field: No Fields 1 Square Feet 1200 Linear Feet 400

No Lines 4x3 Trench Width 36in Max Trench Bottom Depth 36in Gravel Depth 12in

[X] New System [ ] Repair System Type: I, II, III, IV, V, VI

System Description: Gravity Conventional

Repair System Description: Pump Panel Chambers

Maintenance Agreement Required: [ ] Yes [X] No

[X] House/Mod. Home No. Bedrooms 3

[ ] Mobile Home No. Bathrooms 2

[ ] Business No. Employees

[ ] Other


[ ] Slab [X] Crawl Space [ ] Basement w/plumbing [ ] Basement wo/plumbing

Water Supply: [ ] Individual [X] Public [ ] Community


Comments:/Conditions: Keep lines on contour, 9ft on center
smooth out Terrace

Comments:/Conditions:
3 lines Chambers.
Note: lines End feed not split feed

INITIAL SITE SKETCH

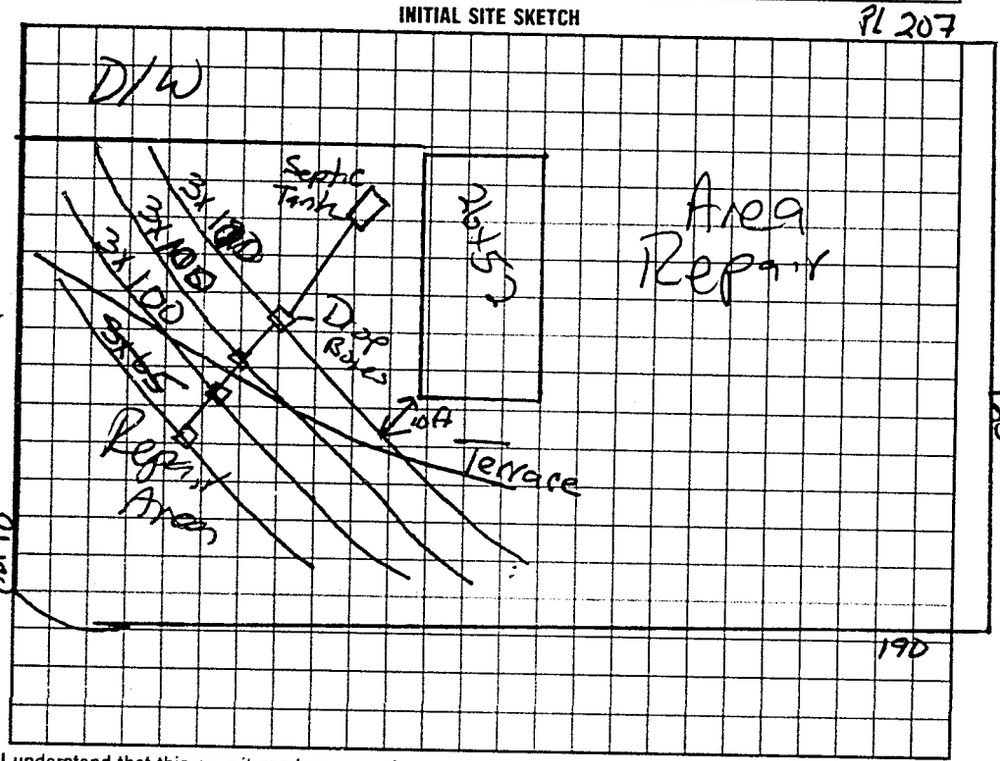

AS BUILT SKETCH

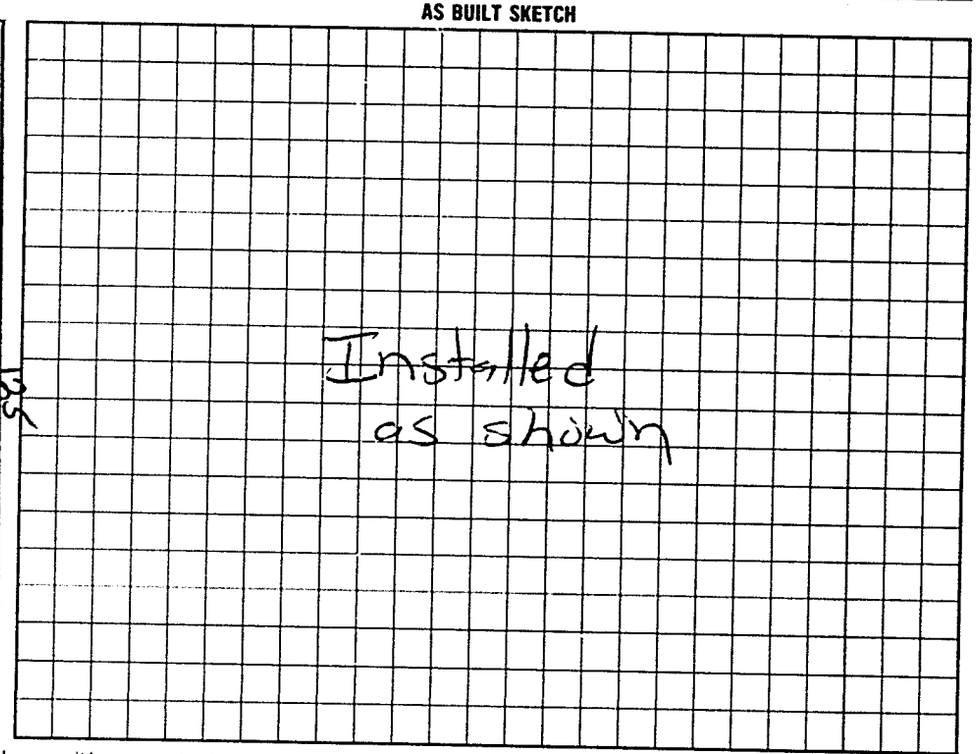

I understand that this permit can be suspended or revoked if any false information is supplied toward securing the permit/any unauthorized changes are made to the site/any unauthorized changes are made in the installation of the system. Improvement Permit with plat valid without expiration. Improvement Permit with site plan valid for sixty months. Authorization to Construct is valid for a period equal to that of Improvement Permit – not to exceed sixty months.

Signed: Terry Lybrook date

Improvement Permit by: Mark C Orf RS date 1-6-98

Authorization to Construct by: Mark C Orf RS date 1-6-98

Installed by: Tommy Fryl

Operation Permit by: Mark C Orf RS date 7-16-98

Existing System Inspection by: date

HEALTH DEPT COPY WHITE INSPECTION COPY (FINAL) GREEN OWNER COPY (FINAL) YELLOW INSPECTION COPY (INITIAL) PINK OWNER COPY (INITIAL) GOLD