IREDELL COUNTY HEALTH DEPARTMENT

STATESVILLE 704-878-5305 MOORESVILLE 704-664-5281

IMPROVEMENT PERMIT / CERTIFICATE OF COMPLETION / OPERATION PERMIT / EXISTING SYSTEM INSPECTION

PROPERTY DESCRIPTION NO. 068057 DATE 7-24-97 TAX MAP NO. 4702290046 Watershed: ☐ Yes ☐ No

OWNER OR CONTRACTOR SunWood Builders PHONE: Business _____ Home _____ WSIVPA

ADDRESS PO Box 5877 Statesville NC

LOCATION 70W TL Eufola on (L) Before Lewis Ferry Rd

SUBDIVISION Brookmeade LOT 3 LOT AREA _____ SITE CLASS. P/S DESIGN FLOW 360 L.T.A.R. 0.3

Septic Tank: 1000 Gallons; STB 1012 Date 4-15-98

Pump Tank: _____ Gallons; PT _____ Date _____

Pump Make: _____ Model _____ Serial No. _____

Nitrification Field: No Fields 1 Square Feet 1200 Linear Feet 400

No Lines 5 Trench Width 36in Max Trench Bottom Depth 36in Gravel Depth 12in

☒ New System ☐ Repair System Type: I, II, III, IV, V, VI

System Description: Conventional Gravity

Repair System Description: Pump Chamber

Maintenance Agreement Required: ☐ Yes ☒ No

☐ House/Mod. Home No. Bedrooms 3

☒ Mobile Home No. Bathrooms 2

☐ Business No. Employees ____

☐ Other _____


☐ Slab ☒ Crawl Space ☐ Basement w/plumbing ☐ Basement wo/plumbing

Water Supply: ☐ Individual ☐ Community ☒ Public


Comments: Keep lines on contour, 9ft on center
Keep water line 10ft from system

Comments: Note Driveway switched to opposite side

INITIAL SITE SKETCH

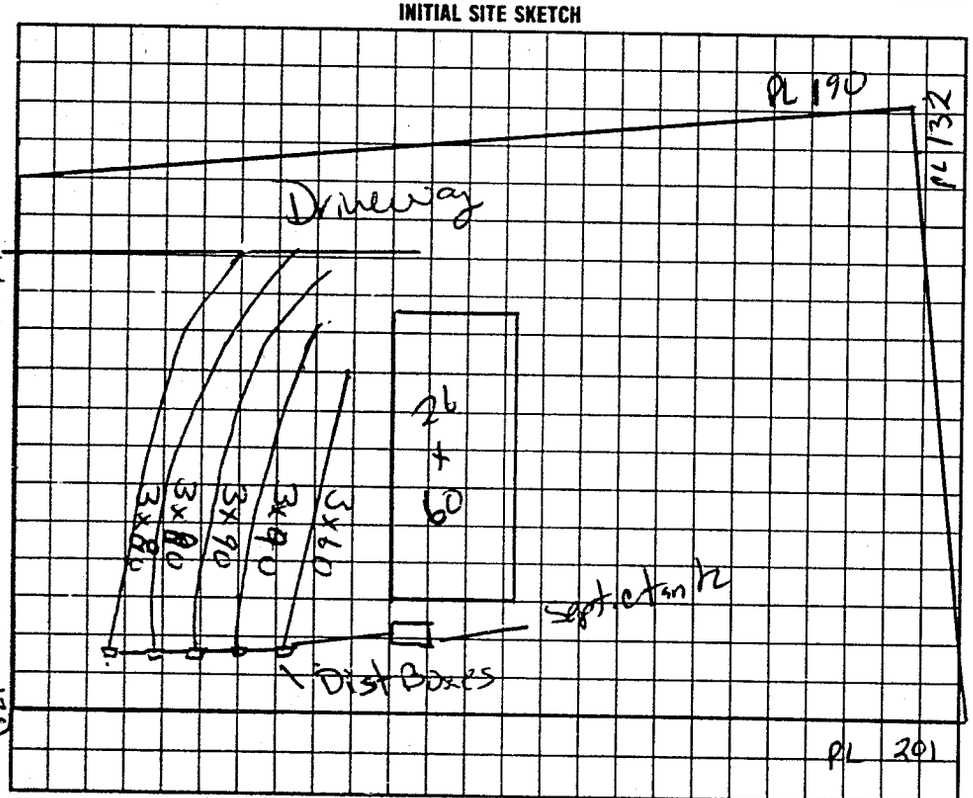

AS BUILT SKETCH

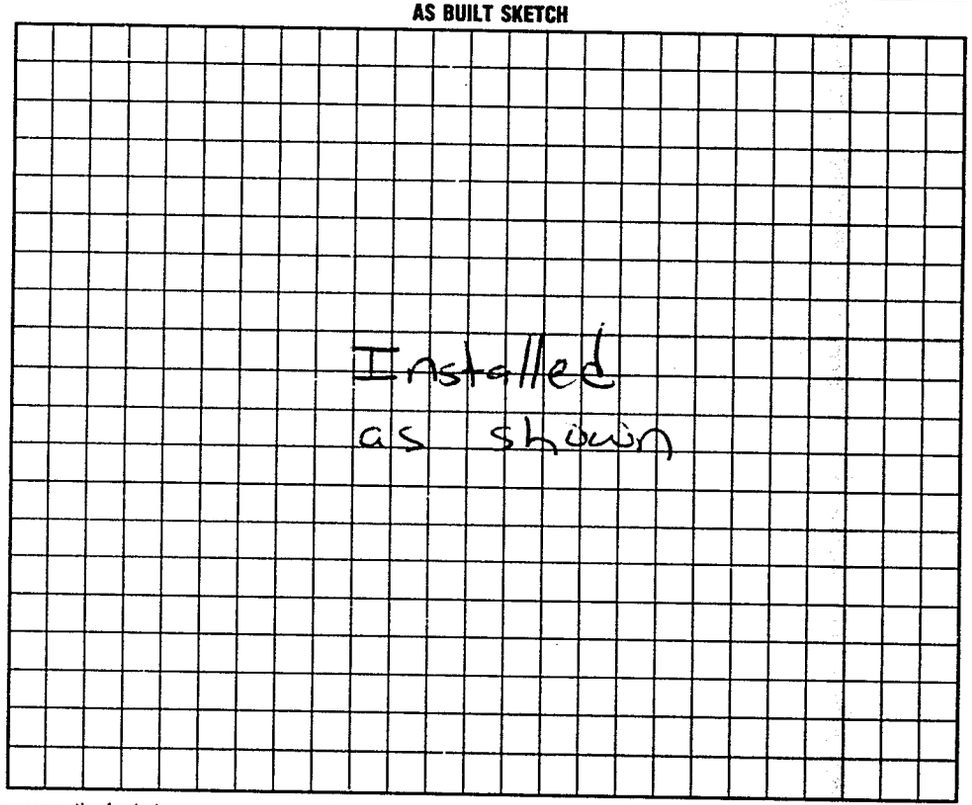

I understand that this permit can be suspended or revoked if any false information is supplied toward securing the permit/any unauthorized changes are made to the site/any unauthorized changes are made in the installation of the system. Improvement Permit is valid for 60 months from date of issuance. Authorization to Construct expires 5 yrs from issue date

Signed: Terry Jenkins

Improvement Permit by: Mark C Autry RS date 7-24-97

Authorization to Construct Mark C Autry RS date 7-24-97

Existing System Inspection by: _____ date _____

Installed by: Tommy Frye

Certificate of Completion by: _____ date _____

Operation Permit by: Mark C Autry RS date 7-16-98

HEALTH DEPT. COPY: WHITE INSPECTION COPY (FINAL): GREEN OWNER COPY (FINAL): YELLOW INSPECTION COPY (INITIAL): PINK OWNER COPY (INITIAL): GOLD