IREDELL COUNTY HEALTH DEPARTMENT

STATESVILLE 704-878-5305 MOORESVILLE 704-664-5281

IMPROVEMENT PERMIT / AUTHORIZATION TO CONSTRUCT / OPERATION PERMIT / EXISTING SYSTEM INSPECTION

DATE 3/7/01

PERMIT# 094804 PIN# 4702 29 6306

OWNER OR CONTRACTOR SUNWOOD BUILDERS PHONE: Business (704) 872-0922 Home

ADDRESS P.O. BOX 5877, STATESVILLE, NC

LOCATION 70 W (L) OLD MTN. RD. (R) LEWIS FERRY (R) EUFOLA RD.

SUBDIVISION BROAD MEADOW BLOCK / SECTION LOT 25 LOT AREA .61 Ac. SITE CLASS. PS DESIGN FLOW 360GPD L.T.A.R. .35

Septic Tank: 1000 Gallons: STB 1072 Date 2-29-01

Pump Tank: Gallons; PT Date

Pump Make: Model Serial No.

Nitrification Field: No Fields 1 Square Feet 1028 Linear Feet 342'

No Lines 3 Trench Width 3' Max Trench Bottom Depth 30" Gravel Depth 12"

☑ New System ☐ Repair System Type: I (II) III. IV. V. VI

System Description: CONVENTIONAL

Repair System Description: 25% REDUCTION

Maintenance Agreement Required: ☐ Yes ☑ No

☐ Slab ☑ Crawl Space ☐ Basement w/plumbing ☐ Basement wo/plumbing

☑ House/Mod. Home No. Bedrooms 3

☐ Mobile Home No. Bathrooms 2

☐ Business No. Employees


☐ Other

Water Supply: ☐ Individual ☑ Public ☐ Community


Comments/Conditions: (1) NO CUTTING OR FILLING OVER DRAINFIELD/REPAIR AREAS (2) KEEP ALL DRAINS AWAY FROM DRAINFIELD/REPAIR AREAS (3) MAINTAIN SETBACKS (4) INSTALL DRAINLINES UNIFORM AND ON CONTOUR

Comments/Conditions: - Poly Lok Filter installed - Septic Tank marker installed

INITIAL SITE SKETCH

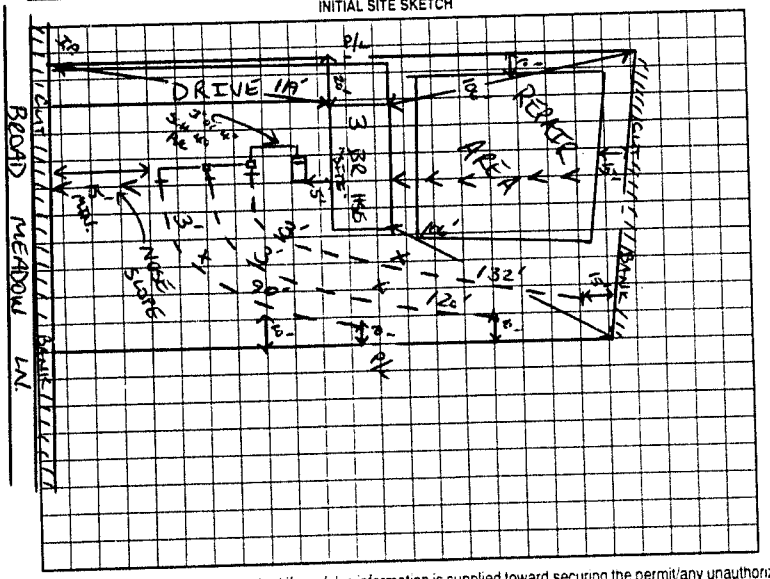

AS BUILT SKETCH Not To Scale

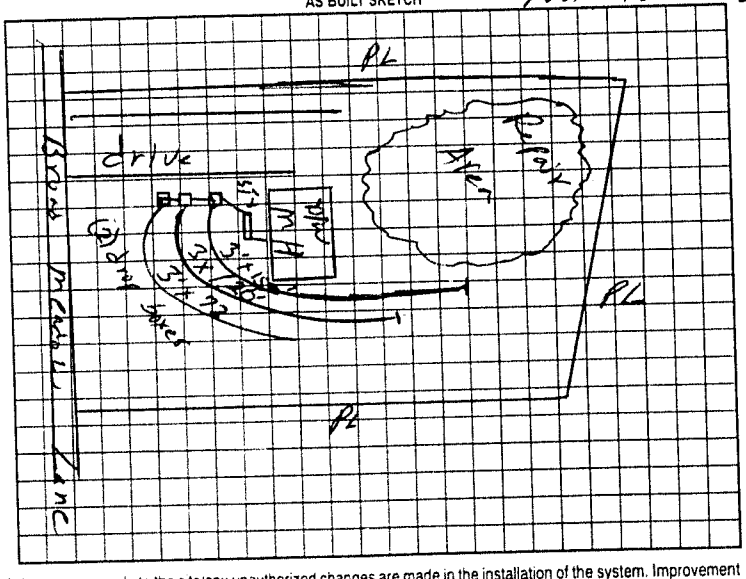

Permit can be suspended or revoked if any false information is supplied toward securing the permit/any unauthorized changes are made to the site/any unauthorized changes are made in the installation of the system. Improvement Permit with plat valid without expiration. Improvement Permit with site plan valid for sixty months. Authorization to Construct is valid for a period equal to that of Improvement Permit – not to exceed sixty months.

Signed: William W Johnson date 3/16/01

Improvement Permit by: Jerry Shinn date 3/7/01

Authorization to Construct by: Jerry Shinn date 3/7/01

Installed by: Tommy Cothren

Operation Permit by: William W Johnson date 6/6/01

Existing System Inspection by: date

HEALTH DEPT COPY WHITE OWNER COPY (FINAL) YELLOW OWNER COPY (INITIAL) PINK