IREDELL COUNTY HEALTH DEPARTMENT

STATESVILLE 704-878-5305 MOORESVILLE 704-664-5281

IMPROVEMENT PERMIT / AUTHORIZATION TO CONSTRUCT / OPERATION PERMIT / EXISTING SYSTEM INSPECTION

PERMIT# 101209 PIN# 4702 380 599 DATE 7/18/01

OWNER OR CONTRACTOR Jenkins & Williams PHONE: Business (704) 872-0922 Home —

ADDRESS 144 Brock Meadow Drive Statesville NC 28677

LOCATION I-40 W, @ Old Mt. Rd, (R) Lewis Ferry Rd, (R) Eufola Rd, (R) Broad Meadows ON Right.

SUBDIVISION Broad Meadow BLOCK / SECTION — LOT 32 LOT AREA 1.036 Ac. SITE CLASS PS DESIGN FLOW 480 L.T.A.R. .03

Septic Tank: 1000 Gallons: STB 1012 Date 6-16-01 | X New System ☐ Repair System Type: I, II, (III) IV, V, VI | ☐ House/Mod. Home No. Bedrooms 4 | Water Supply: ☐ Individual

Pump Tank: — Gallons: PT — Date — | System Description: Gravity 25% Reduction | X Mobile Home No. Bathrooms 2½ | X Public ☐ Community

Pump Make: — Model — Serial No. — | Repair System Description: Gravity, 25% Reduction | ☐ Business No. Employees —


Nitrification Field: No Fields 1 Square Feet Equivalent to 1600 Linear Feet 400 | Maintenance Agreement Required. ☐ Yes X No | ☐ Other —

No Lines 5 Trench Width 36" Max Trench Bottom Depth 36" Gravel Depth 12" | ☐ Slab X Crawl Space ☐ Basement w/plumbing ☐ Basement wo/plumbing


Comments/Conditions: ① Install lines on contour ② Install 25% Reduction System - 67 Chambers or 40 - 10ft HOES sections ③ Keep 10ft off property lines

Comments/Conditions: - Septic Tank marker Installed - Poly Lok Filter Installed - Installed 67 Chambers Infiltrator 1-13; 2-14; 3-14; 4-14; 5-13

INITIAL SITE SKETCH Not to Scale

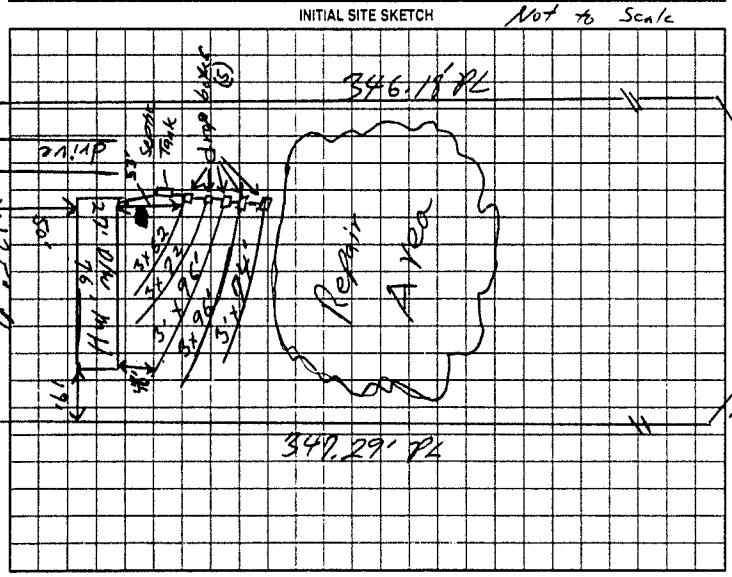

AS BUILT SKETCH

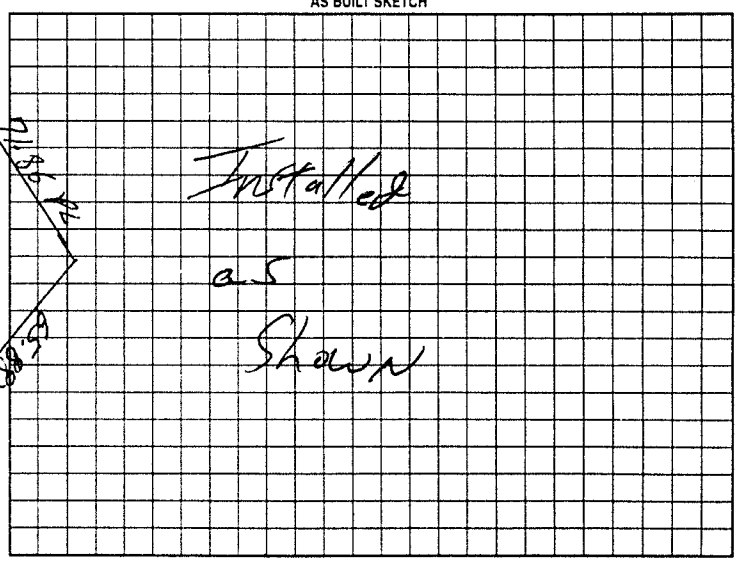

Permit can be suspended or revoked if any false information is supplied toward securing the permit/any unauthorized changes are made to the site/any unauthorized changes are made in the installation of the system. Improvement Permit with plat valid without expiration. Improvement Permit with site plan valid for sixty months. Authorization to Construct is valid for a period equal to that of Improvement Permit - not to exceed sixty months.

Signed: Jerry W Jenkins date 8/11/01 Installed by: Joey Gotherm

Improvement Permit by: William O Johnson date 7/18/01 Operation Permit by: William O Johnson date 8/21/01

Authorization to Construct by: William O Johnson date 7/18/01 Existing System Inspection by: — date —

HEALTH DEPT. COPY WHITE OWNER COPY (FINAL) YELLOW OWNER COPY (INITIAL) PINK