IREDELL COUNTY HEALTH DEPARTMENT

STATESVILLE 704-878-5305 MOORESVILLE 704-664-5281

IMPROVEMENT PERMIT / AUTHORIZATION TO CONSTRUCT / OPERATION PERMIT / EXISTING SYSTEM INSPECTION

PERMIT# 094493 PIN# 4702 29 6306 DATE 2/19/01

OWNER OR CONTRACTOR SUNWOOD BUILDERS, (PERRY JENKINS) PHONE: Business (704) 872-0922 Home

ADDRESS P.O. BOX 5877, STATESVILLE, NC 28687

LOCATION 70 W, (L) OLD MTN. RD. (R) LEWIS FERRY RD. (R) EUFOLA RD (R) BROAD MEADOW TO LOT ON (L)

SUBDIVISION BROAD MEADOW BLOCK / SECTION 4 LOT 24 LOT AREA .62 Ac. SITE CLASS PS DESIGN FLOW 360 GPD L.T.A.R. .30

Septic Tank: 1000 Gallons; STB 10/2 Date 2/26/01
Pump Tank: Gallons; PT Date
Pump Make: Model Serial No
Nitrification Field: No Fields 1 Square Feet 1200 Linear Feet 300'
No Lines 4 Trench Width 3' Max Trench Bottom Depth 30" Gravel Depth N/A

☑ New System ☐ Repair System Type: I, II, (III), IV, V, VI
System Description: 25% REDUCTION
Repair System Description: SAME
Maintenance Agreement Required: ☐ Yes ☑ No
☐ Slab ☑ Crawl Space ☐ Basement w/plumbing ☐ Basement wo/plumbing


☐ House/Mod. Home No. Bedrooms 3
☑ Mobile Home No. Bathrooms 2
☐ Business No. Employees
☐ Other

Water Supply: ☐ Individual ☑ Public ☐ Community


Comments/Conditions: (1) NO CUTTING OR FILLING OVER DRAINFIELD/ REPAIR AREAS (2) KEEP ALL DRAINS AWAY FROM DRAINFIELD/ REPAIR AREAS (3) MAINTAIN SETBACKS (4) INSTALL DRAINLINES UNIFORM AND ON CONTOUR.

Comments/Conditions: 4/30/01 - CHECKED TANK
- Installed Septic Tank risers
- Installed 10x16K filter
- 48 ● Infiltrator Chambers Installed

INITIAL SITE SKETCH

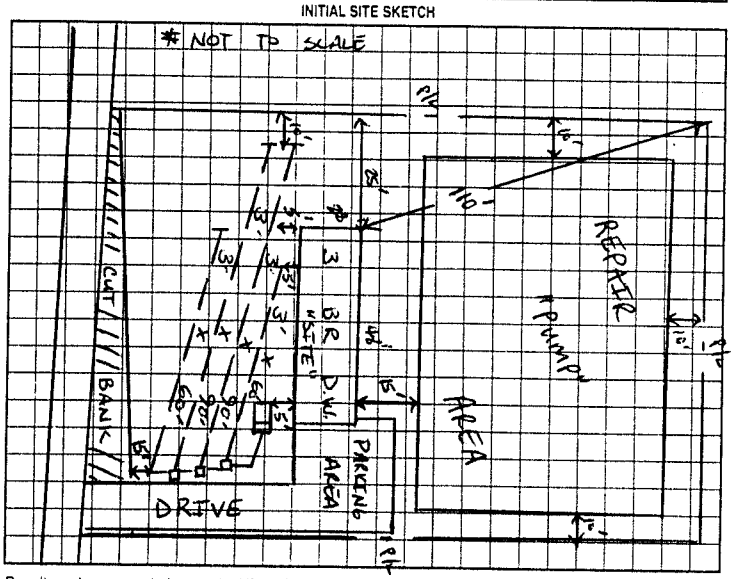

AS BUILT SKETCH

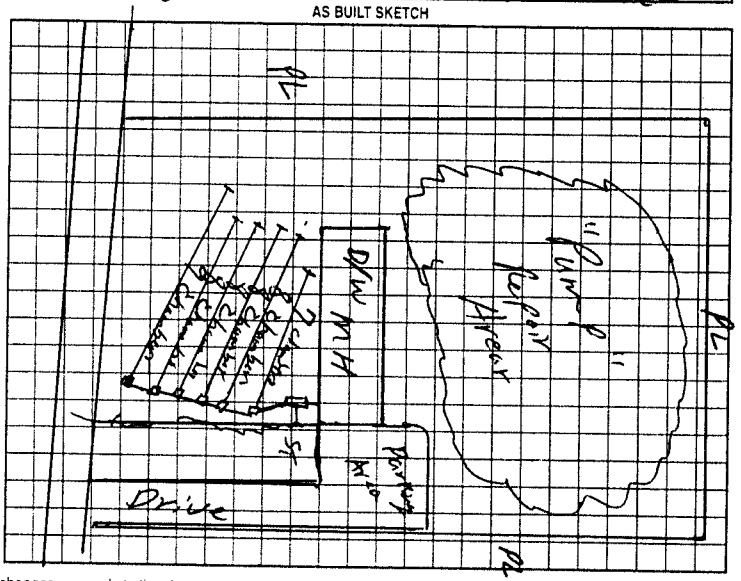

Permit can be suspended or revoked if any false information is supplied toward securing the permit/any unauthorized changes are made to the site/any unauthorized changes are made in the installation of the system. Improvement Permit with plat valid without expiration. Improvement Permit with site plan valid for sixty months. Authorization to Construct is valid for a period equal to that of Improvement Permit – not to exceed sixty months.

Signed: Perry Jenkins date 2/21/01 Installed by: Tommy Cathcart

Improvement Permit by: Tracy Stines date 2/19/01 Operation Permit by: William J. Johnson RSI date 5-18-01

Authorization to Construct by: Tracy Stines date 2/19/01 Existing System Inspection by: date

HEALTH DEPT. COPY. WHITE OWNER COPY (FINAL) YELLOW OWNER COPY (INITIAL) PINK