IREDELL COUNTY HEALTH DEPARTMENT

STATESVILLE 704-878-5305 MOORESVILLE 704-664-5281

IMPROVEMENT PERMIT / AUTHORIZATION TO CONSTRUCT / OPERATION PERMIT / EXISTING SYSTEM INSPECTION

PERMIT# 076355 PIN# 4702 39 2209 (PART) DATE 9-11-98

OWNER OR CONTRACTOR SUNWOOD BUILDERS PHONE: Business 872-0921 Home

ADDRESS P.O. BOX 5877, STATESVILLE, NC 28687

LOCATION US 70 W TL EUFOLA ROAD, TR BROAD MEADOW DRIVE, 4th LOT ON LEFT

SUBDIVISION BROAD MEADOW BLOCK / SECTION LOT 8 LOT AREA 0.659 ACRE SITE CLASS PS1 DESIGN FLOW 360 L.T.A.R. 0.33 GPD/FT

Septic Tank: 1000 Gallons; STB 1012 Date 10-19-99
Pump Tank: Gallons; PT Date
Pump Make: Model Serial No.
Nitrification Field: No Fields 1 Square Feet 1080 Linear Feet 360
No Lines SIX Trench Width 36" Max Trench Bottom Depth 36" Gravel Depth 12"

☑ New System ☐ Repair System Type: I, II, III, IV, V, VI
System Description: CONVENTIONAL SPANTY
Repair System Description: 25% REDUCTION PUMP
Maintenance Agreement Required: ☐ Yes ☑ No
☐ Slab ☑ Crawl Space ☐ Basement w/plumbing ☐ Basement wo/plumbing

☐ House/Mod. Home No. Bedrooms 3
☑ Mobile Home No. Bathrooms 2
☐ Business No. Employees
☐ Other


Water Supply: ☐ Individual ☑ Public ☐ Community

Comments:/Conditions: ① CONSTRUCT SUBSURFACE INTERCEPT DRAINAGE DITCH AT LOCATION SHOWN BEGINNING 48" DEEP OUT TO CULVERT DEPTH ② USE ONE FLOW DIVIDER TEE TO ACHIEVE EQUAL DISTRIBUTION TO TWO SETS OF DROP BOXES AS SHOWN.


Comments:/Conditions:

SCALE: 1" = 40'

INITIAL SITE SKETCH

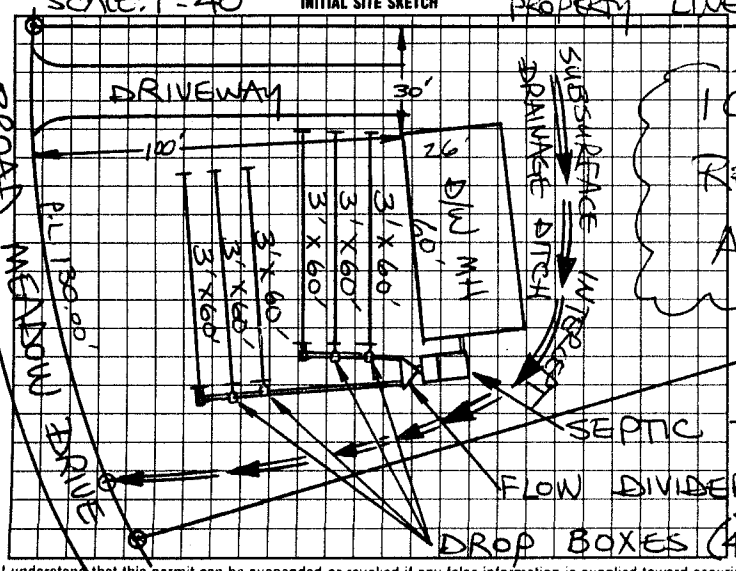

AS BUILT SKETCH

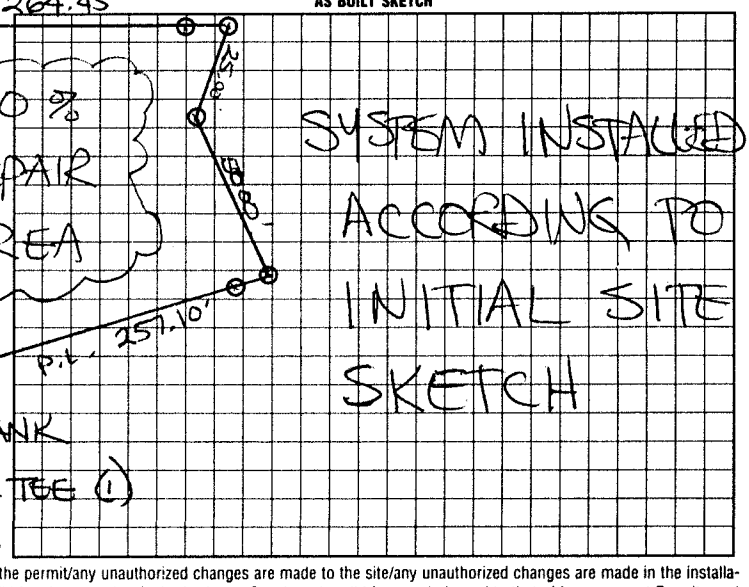

I understand that this permit can be suspended or revoked if any false information is supplied toward securing the permit/any unauthorized changes are made to the site/any unauthorized changes are made in the installation of the system. Improvement Permit with plat valid without expiration. Improvement Permit with site plan valid for sixty months. Authorization to Construct is valid for a period equal to that of Improvement Permit – not to exceed sixty months.

Signed: [signature] date 9/14/98

Improvement Permit by: STEVE HEDRICK date 9-11-98

Authorization to Construct by: STEVE HEDRICK date 9-11-98

Installed by: TOMMY FRYE

Operation Permit by: STEVE HEDRICK date 1-20-99

Existing System Inspection by: date

HEALTH DEPT. COPY: WHITE INSPECTION COPY (FINAL): GREEN OWNER COPY (FINAL): YELLOW INSPECTION COPY (INITIAL): PINK OWNER COPY (INITIAL): GOLD