IREDELL COUNTY HEALTH DEPARTMENT

STATESVILLE 704-878-5305 MOORESVILLE 704-664-5281

IMPROVEMENT PERMIT / AUTHORIZATION TO CONSTRUCT / OPERATION PERMIT / EXISTING SYSTEM INSPECTION

PERMIT# 076805 PIN# 4702 29 9046 DATE 10-10-98

OWNER OR CONTRACTOR SUNWOOD BUILDERS PHONE: Business _____ Home 872-5066

ADDRESS P.O. BOX 5877, STATESVILLE, NC 28687

LOCATION US 70 WEST, TL EULA ROAD, TL BROAD MEADOW DRIVE, 4TH LOT ON RIGHT

SUBDIVISION BROAD MEADOW BLOCK / SECTION II LOT 11 LOT AREA 0.698+ ACRES SITE CLASS PS I DESIGN FLOW 360 L.T.A.R. 0.30 gpd/ft²

Septic Tank: 1000 Gallons; STB 1012 Date 10-29-00
Pump Tank: _____ Gallons; PT _____ Date _____
Pump Make: _____ Model _____ Serial No. _____
Nitrification Field: No Fields 1 Square Feet 69.10 1200 Linear Feet 300+
No Lines FIVE Trench Width 36" Max Trench Bottom Depth 36"

☒ New System ☐ Repair System Type: I, II, III, IV, V, VI
System Description: 25% REDUCTION GRAVITY
Repair System Description: 25% REDUCTION PUMP
Maintenance Agreement Required: ☐ Yes ☒ No
~~Gravel~~ Depth 6" SAND ☐ Slab ☒ Crawl Space ☐ Basement w/plumbing ☐ Basement wo/plumbing


☐ House/Mod. Home No. Bedrooms 3
☒ Mobile Home No. Bathrooms 2
☐ Business No. Employees _____
☐ Other _____

Water Supply: ☐ Individual ☒ Public ☐ Community


Comments/Conditions: ① RELOCATE PROPERTY LINE AS SHOWN. ② INSTALL 50 CHAMBERS AT REQUEST IN FIVE LINES ON CONTOUR.

Comments/Conditions: - polyfelt Filter installed, Septic Tank marked installed, Installed 50 Chamber on Contour. - Changes From original design approved by Health Dept prior to Actual construction.

INITIAL SITE SKETCH SCALE: 1"=40'

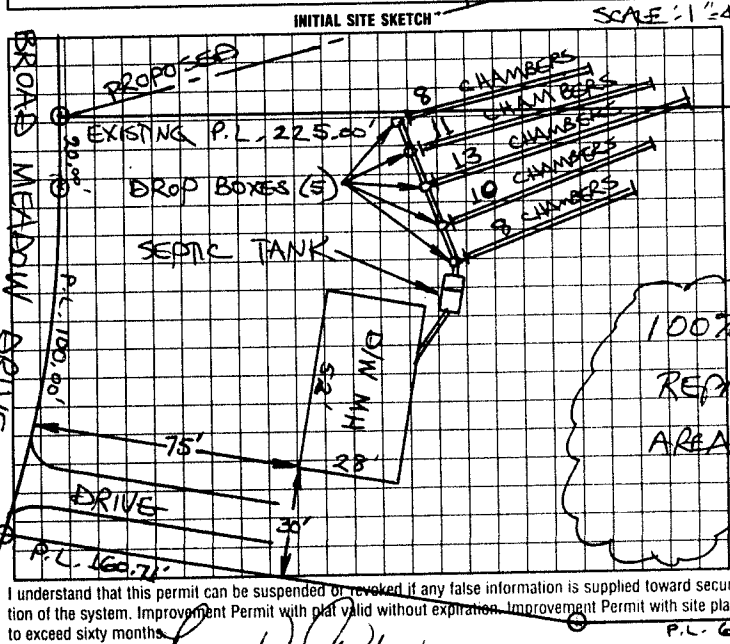

AS BUILT SKETCH

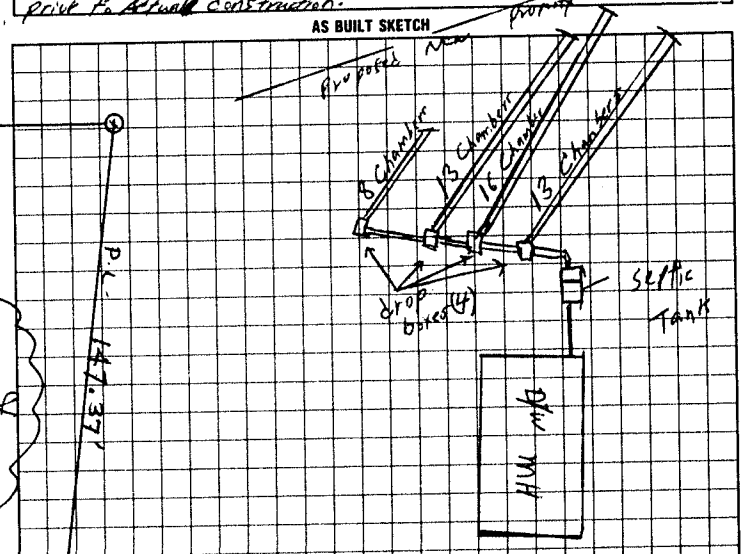

I understand that this permit can be suspended or revoked if any false information is supplied toward securing the permit/any unauthorized changes are made to the site/any unauthorized changes are made in the installation of the system. Improvement Permit with plat valid without expiration. Improvement Permit with site plan valid for sixty months. Authorization to Construct is valid for a period equal to that of Improvement Permit – not to exceed sixty months.

Signed: Terry W Roberts date _____ Installed by: Tommy Cothern

Improvement Permit by: STEVE HEDRICK date 10-10-98 Operation Permit by: William G Johnson RSE date 1-16-01

Authorization to Construct by: STEVE HEDRICK date 10-10-98 Existing System Inspection by: _____ date _____

HEALTH DEPT. COPY: WHITE INSPECTION COPY (FINAL): GREEN OWNER COPY (FINAL): YELLOW INSPECTION COPY (INITIAL): PINK OWNER COPY (INITIAL): GOLD