IREDELL COUNTY HEALTH DEPARTMENT

STATESVILLE 704-878-5305 MOORESVILLE 704-664-5281

IMPROVEMENT PERMIT / AUTHORIZATION TO CONSTRUCT / OPERATION PERMIT / EXISTING SYSTEM INSPECTION

PERMIT# 075818 PIN# 4702 39 2209 (PT) DATE 8-4-98

OWNER OR CONTRACTOR SUNWOOD BUILDERS PHONE: Business 872-0921 Home

ADDRESS P.O. BOX 5877, STATESVILLE, NC 28687

LOCATION I-40 W, TL O.M.R, TR LEWIS FERRY RD, TR EUFOLA RD, TR BROAD MEADOW DRIVE, 2ND LOT ON LEFT

SUBDIVISION ~~BROAD MEADOW~~ BLOCK / SECTION LOT 6 LOT AREA 0.687 Ac SITE CLASS. PS DESIGN FLOW 360 L.T.A.R. 0.30 gpd/ft²

Septic Tank: 1000 Gallons; STB 1012 Date 6-23-98

Pump Tank: Gallons; PT Date

Pump Make: Model Serial No.

Nitrification Field: No Fields 1 Square Feet EQ. to 200 Linear Feet 300+

No Lines FIVE Trench Width 36" Max Trench Bottom Depth 36"

☑ New System ☐ Repair System Type: I, II, III, IV, V, VI

System Description: ~~STANDARD~~ CHAMBER

Repair System Description: 25% REDUCTION ~~CHAMBER~~ BED

Maintenance Agreement Required: ☐ Yes ☑ No

~~Gravel~~ Depth SAND 6"

☐ House/Mod. Home ☑ Mobile Home ☐ Business ☐ Other

No. Bedrooms 3 No. Bathrooms 2 No. Employees


☐ Slab ☑ Crawl Space ☐ Basement w/plumbing ☐ Basement wo/plumbing

Water Supply: ☐ Individual ☑ Public ☐ Community


Comments:/Conditions: INSTALL 25% REDUCTION SYSTEM USING FIFTY CHAMBERS OF TARM HDS SECTIONS ON CONTOUR USING DISTRIBUTION BOXES FOR SERIAL DISTRIBUTION

Comments:/Conditions: Tookset 8-25

INITIAL SITE SKETCH SCALE: 1"=40'

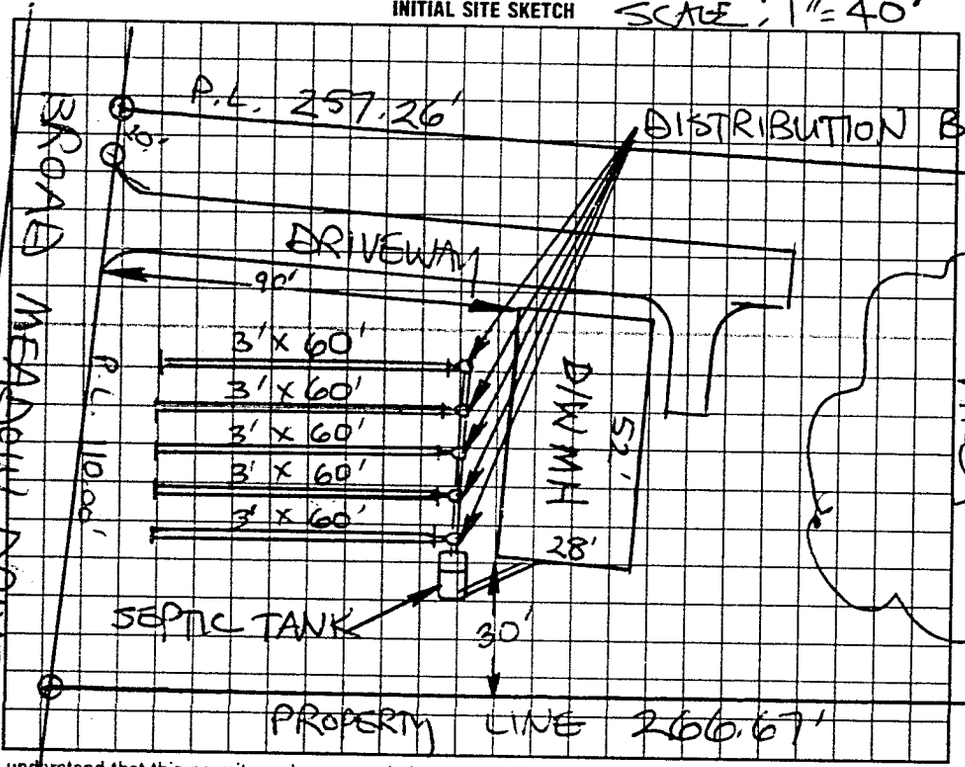

AS BUILT SKETCH

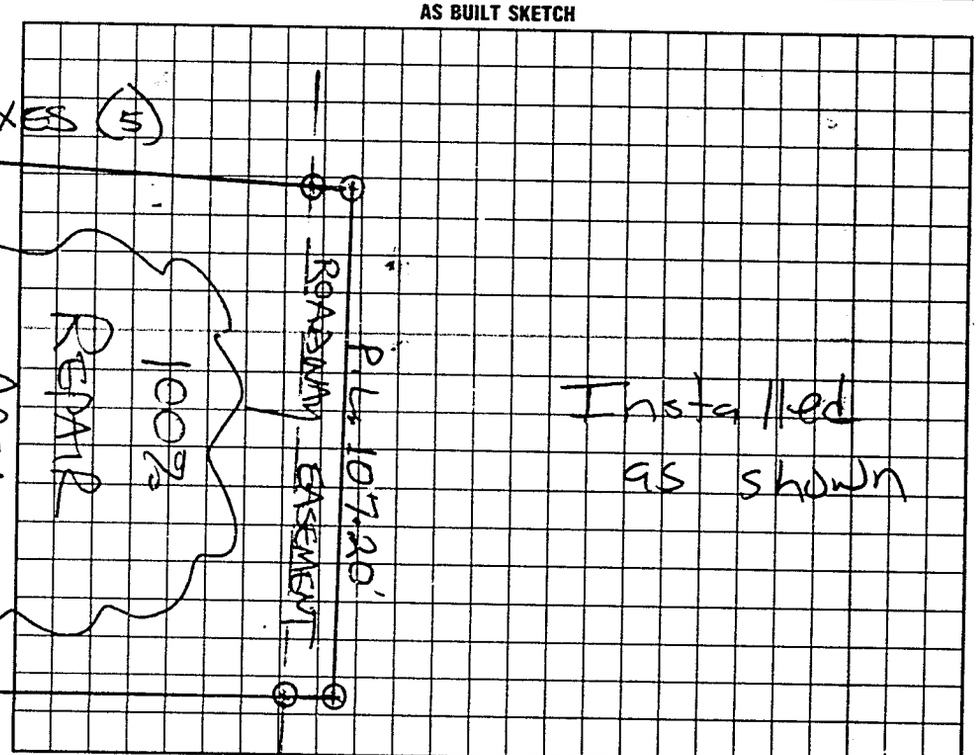

I understand that this permit can be suspended or revoked if any false information is supplied toward securing the permit/any unauthorized changes are made to the site/any unauthorized changes are made in the installation of the system. Improvement Permit with plat valid without expiration. Improvement Permit with site plan valid for sixty months. Authorization to Construct is valid for a period equal to that of Improvement Permit – not to exceed sixty months.

Signed: date 8/4/98

Improvement Permit by: STEVE HEDRICK date 8-4-98

Authorization to Construct by: STEVE HEDRICK date 8-4-98

Installed by: Tommy Frye

Operation Permit by: C Dyl PS date 9-3-98

Existing System Inspection by: date

HEALTH DEPT. COPY: WHITE INSPECTION COPY (FINAL): GREEN OWNER COPY (FINAL): YELLOW INSPECTION COPY (INITIAL): PINK OWNER COPY (INITIAL): GOLD