IREDELL COUNTY HEALTH DEPARTMENT

STATESVILLE 704-878-5305 MOORESVILLE 704-664-5281

IMPROVEMENT PERMIT / AUTHORIZATION TO CONSTRUCT / OPERATION PERMIT / EXISTING SYSTEM INSPECTION

PERMIT# 075567 PIN# 4702392209 (PT) DATE 8-4-98

OWNER OR CONTRACTOR SUNWOOD BUILDERS PHONE: Business 872-0921 Home

ADDRESS P.O. BOX 5877, STATESVILLE, NC 28687

LOCATION I-40 W, TL O.M.R., TR LEWIS FERRY RD, TR EUFOLA RD, TR BROAD MEADOW DRIVE, 3RD LOT ON LEFT

SUBDIVISION BROAD MEADOW BLOCK / SECTION LOT 7 LOT AREA 0.684 ACRE SITE CLASS. PS DESIGN FLOW 360 L.T.A.R. 0.38 GPD/FT²

Septic Tank: 1000 Gallons; STB 1012 Date 6-23-98
Pump Tank: Gallons; PT Date
Pump Make: Model Serial No.
Nitrification Field: No Fields 1 Square Feet 1080 Linear Feet 360
No Lines FOUR Trench Width 36" Max Trench Bottom Depth 36" Gravel Depth 12"

☑ New System ☐ Repair System Type: I, II, III, IV, V, VI
System Description: CONVENTIONAL GRAVITY
Repair System Description: CONV. GRAV./PUMP
Maintenance Agreement Required: ☐ Yes ☑ No

☐ House/Mod. Home ☑ Mobile Home ☐ Business ☐ Other
No. Bedrooms 3 No. Bathrooms 2 No. Employees


☐ Slab ☑ Crawl Space ☐ Basement w/plumbing ☐ Basement wo/plumbing

Water Supply: ☐ Individual ☑ Public ☐ Community


Comments:/Conditions:

Comments:/Conditions: Tank set 8-25

SCALE: 1"=40' INITIAL SITE SKETCH

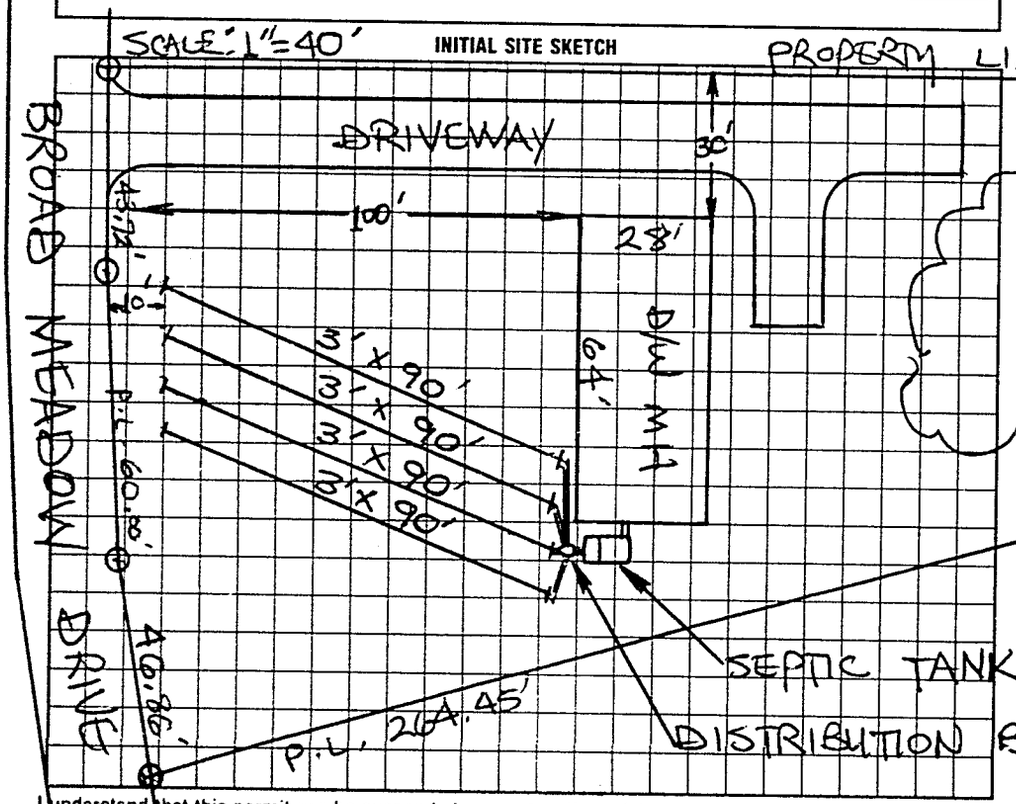

AS BUILT SKETCH

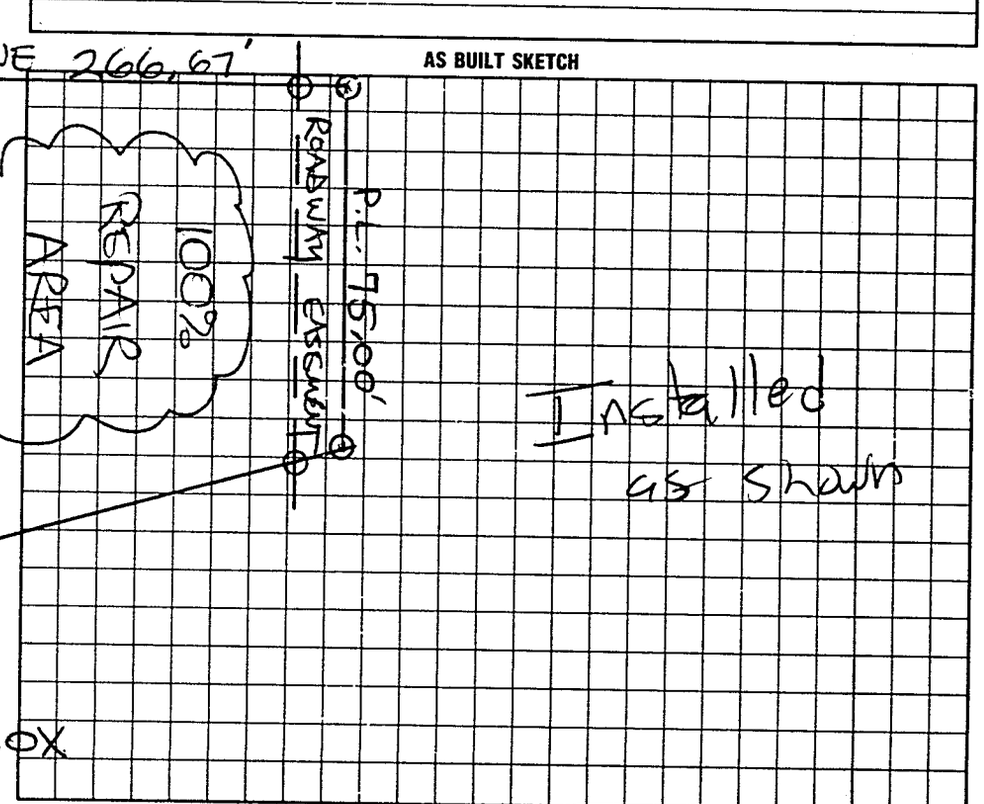

I understand that this permit can be suspended or revoked if any false information is supplied toward securing the permit/any unauthorized changes are made to the site/any unauthorized changes are made in the installation of the system. Improvement Permit with plat valid without expiration. Improvement Permit with site plan valid for sixty months. Authorization to Construct is valid for a period equal to that of Improvement Permit – not to exceed sixty months.

Signed: date 8/4/98

Improvement Permit by: STEVE HEDRICK date 8-4-98

Authorization to Construct by: STEVE HEDRICK date 8-4-98

Installed by: Tommy Fry

Operation Permit by: date 9-3-98

Existing System Inspection by: date

HEALTH DEPT. COPY: WHITE INSPECTION COPY (FINAL): GREEN OWNER COPY (FINAL): YELLOW INSPECTION COPY (INITIAL): PINK OWNER COPY (INITIAL): GOLD