IREDELL COUNTY HEALTH DEPARTMENT

STATESVILLE 704-878-5305 MOORESVILLE 704-664-5281

IMPROVEMENT PERMIT / AUTHORIZATION TO CONSTRUCT / OPERATION PERMIT / EXISTING SYSTEM INSPECTION

PERMIT# 80203 PIN# 4702279046

OWNER OR CONTRACTOR Sunwood Builders PHONE: Business 872-0922 Home

DATE 4-9-99

ADDRESS Po Box 5877 Statesville N.C.

LOCATION Enfola Rd Turn Broad meadow TR cripple creek 4th lot left

SUBDIVISION Broadmeadow BLOCK / SECTION 3 LOT 21 LOT AREA 1.87 acres SITE CLASS 1Ps DESIGN FLOW 360 L.T.A.R. .33

Septic Tank: 1000 Gallons; STB 1012 Date 8-27-02

Pump Tank: Gallons; PT Date

Pump Make: Model Serial No.

Nitrification Field: No Fields 1 Square Feet 1080 Linear Feet 360

No Lines 3 Trench Width 36" Max Trench Bottom Depth 36" Gravel Depth 12"

New System Repair System Type: I II III IV V VI

System Description: Conv. Gravity

Repair System Description:

Maintenance Agreement Required: Yes No

Slab Crawl Space Basement w/plumbing Basement wo/plumbing

House/Mod. Home No. Bedrooms 3

Mobile Home No. Bathrooms 2

Business No. Employees

Other


Water Supply: Individual Public Community

Comments/Conditions:


Comments/Conditions

* House set back Farther

INITIAL SITE SKETCH 313

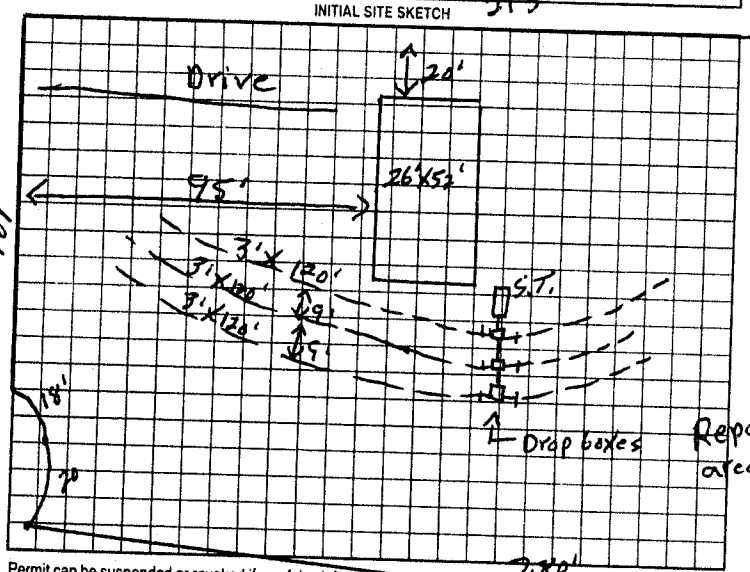

AS BUILT SKETCH

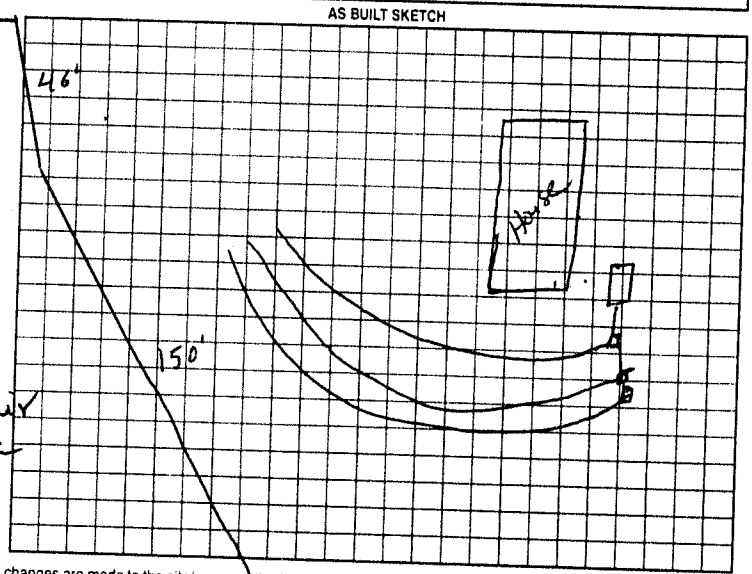

Permit can be suspended or revoked if any false information is supplied toward securing the permit/any unauthorized changes are made to the site/any unauthorized changes are made in the installation of the system. Improvement Permit with plat valid without expiration. Improvement Permit with site plan valid for sixty months. Authorization to Construct is valid for a period equal to that of Improvement Permit – not to exceed sixty months.

Signed: date

Improvement Permit by: R. C. Moore date 4-9-99

Authorization to Construct by: R. C. Moore date 4-9-99

Installed by: Tommy Cothren

Operation Permit by: Mary C Bufkins date 11-1-00

Existing System Inspection by: date

HEALTH DEPT. COPY WHITE OWNER COPY (FINAL) YELLOW OWNER COPY (INITIAL) PINK