IREDELL COUNTY HEALTH DEPARTMENT

STATESVILLE 704-878-5305 MOORESVILLE 704-664-5281

IMPROVEMENT PERMIT / AUTHORIZATION TO CONSTRUCT / OPERATION PERMIT / EXISTING SYSTEM INSPECTION

PERMIT# 80204 PIN# 4702299046 DATE 4-9-99

OWNER OR CONTRACTOR Sunwood Builders PHONE: Business 704 872 0922 Home

ADDRESS PO Box 5870 Statesville

LOCATION Euforo Rd Turn Broad meadow TR Cripple Creek 2nd Lot Left

SUBDIVISION Broad meadow BLOCK / SECTION 3 LOT 23 LOT AREA .53 SITE CLASS PS DESIGN FLOW 360 L.T.A.R. .133

Septic Tank: 1000 Gallons; STB Date

Pump Tank: Gallons, PT Date

Pump Make: Model Serial No.

Nitrification Field: No Fields 1 Square Feet 1080 Linear Feet 360

No Lines 3 Trench Width 36" Max Trench Bottom Depth 36" Gravel Depth 12"

☑ New System ☐ Repair System Type: ☐ I ☑ III ☐ IV ☐ V ☐ VI

System Description: conv. Gravity

Repair System Description: 25 Bed "

Maintenance Agreement Required: ☐ Yes ☑ No

☐ House/Mod. Home ☐ Mobile Home ☐ Business ☐ Other

No. Bedrooms 3 No. Bathrooms 2 No. Employees


☐ Slab ☑ Crawl Space ☐ Basement w/plumbing ☐ Basement wo/plumbing

Water Supply: ☐ Individual ☑ Public ☐ Community


Comments/Conditions:

Comments/Conditions

INITIAL SITE SKETCH

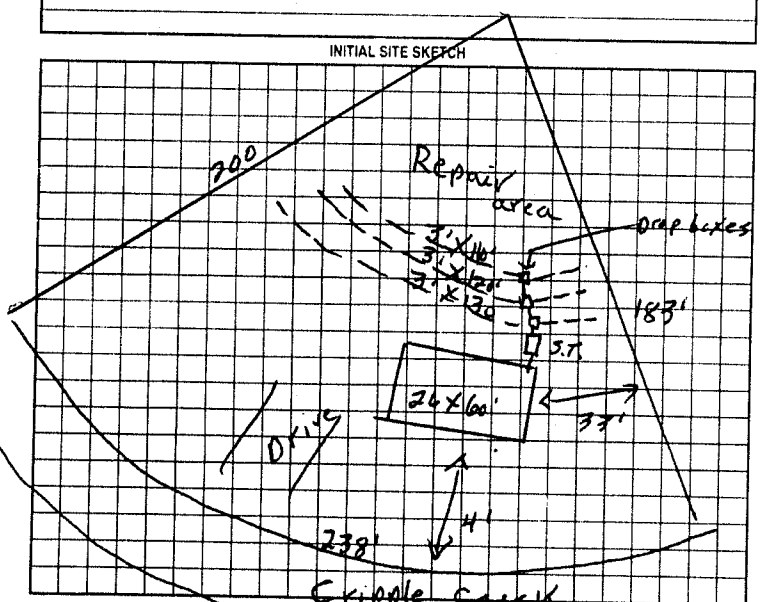

AS BUILT SKETCH

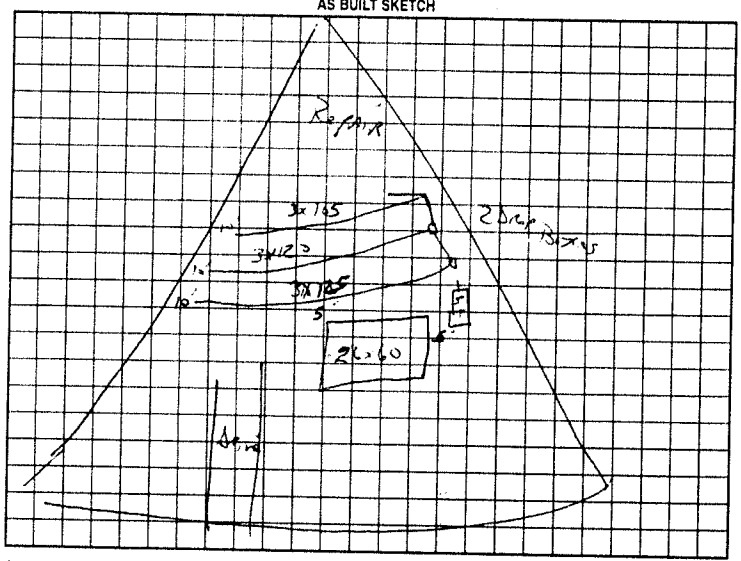

Permit can be suspended or revoked if any false information is supplied toward securing the permit/any unauthorized changes are made to the site/any unauthorized changes are made in the installation of the system. Improvement Permit with plat valid without expiration. Improvement Permit with site plan valid for sixty months. Authorization to Construct is valid for a period equal to that of Improvement Permit – not to exceed sixty months.

Signed: Tony Yarbrough date

Improvement Permit by: R.C. moore date 4-9-99

Authorization to Construct by: R.C. moore date 4-9-99

Installed by: Tommy Fry

Operation Permit by: C Potter date 5-25-99

Existing System Inspection by: date

HEALTH DEPT COPY WHITE OWNER COPY (FINAL) YELLOW OWNER COPY (INITIAL) PINK