IREDELL COUNTY HEALTH DEPARTMENT

STATESVILLE 704-878-5305 MOORESVILLE 704-664-5281

IMPROVEMENT PERMIT / CERTIFICATE OF COMPLETION / OPERATION PERMIT / EXISTING SYSTEM INSPECTION

PROPERTY DESCRIPTION NO. 068056 DATE 7-23-97 TAX MAP NO. 4702 29 9046 Watershed: ☐ Yes ☐ No

OWNER OR CONTRACTOR Sunwood Builders PHONE: Business 8720921 Home

ADDRESS PO Box 5877 Statesville NC

LOCATION TOWTL Eufola on (L) Before Lew's Ferry Rd

SUBDIVISION Bread Meadow BLOCK / SECTION LOT 2 LOT AREA 21780 SITE CLASS. P/S DESIGN FLOW 360 L.T.A.R. 0.3

Septic Tank: 1000 Gallons; STB Date

Pump Tank: Gallons; PT Date

Pump Make: Model Serial No.

Nitrification Field: No Fields 1 Square Feet Linear Feet

No Lines Trench Width 36in Max Trench Bottom Depth 24-36in Gravel Depth 12in

☒ New System ☐ Repair System Type: I, ☒ II, III, IV, V, VI

System Description: Grant Conventional

Repair System Description: Pump Chamber

Maintenance Agreement Required: ☐ Yes ☐ No

☐ House/Mod. Home ☒ Mobile Home ☐ Business ☐ Other

No. Bedrooms 3 No. Bathrooms 2 No. Employees


☐ Slab ☒ Crawl Space ☐ Basement w/plumbing ☐ Basement wo/plumbing

Water Supply: ☐ Individual ☐ Community ☒ Public


Comments: Keep lines on Contour, 9ft on center
Keep water line 10ft from system

Comments:

INITIAL SITE SKETCH

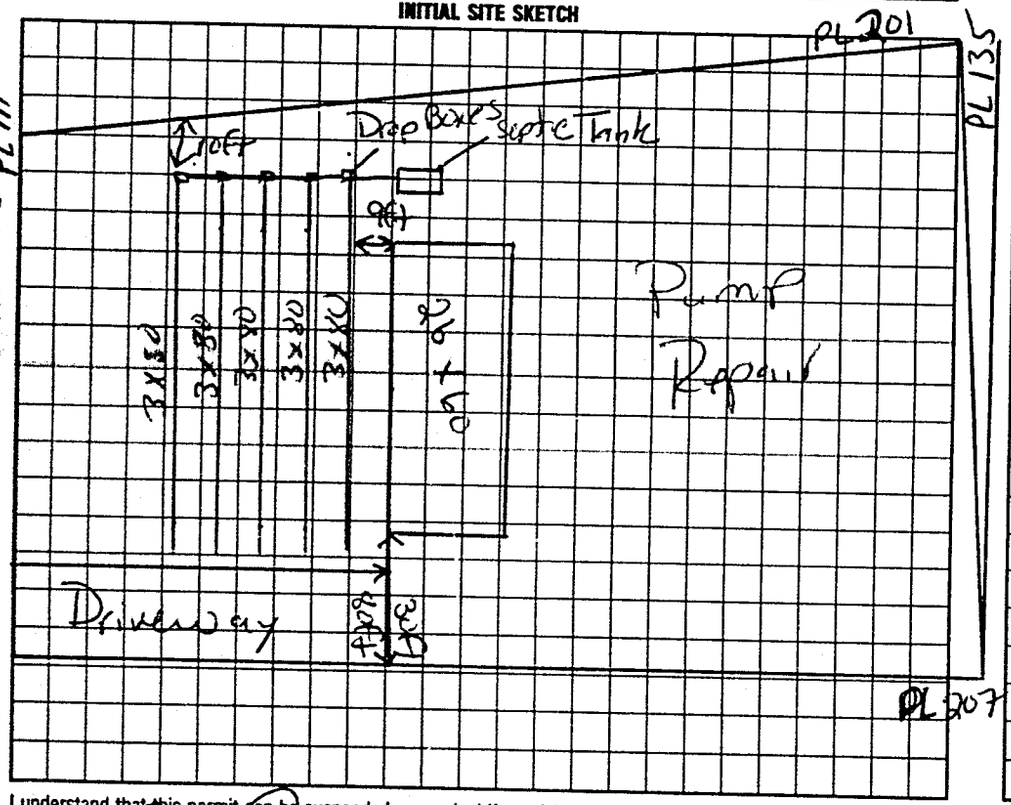

AS BUILT SKETCH

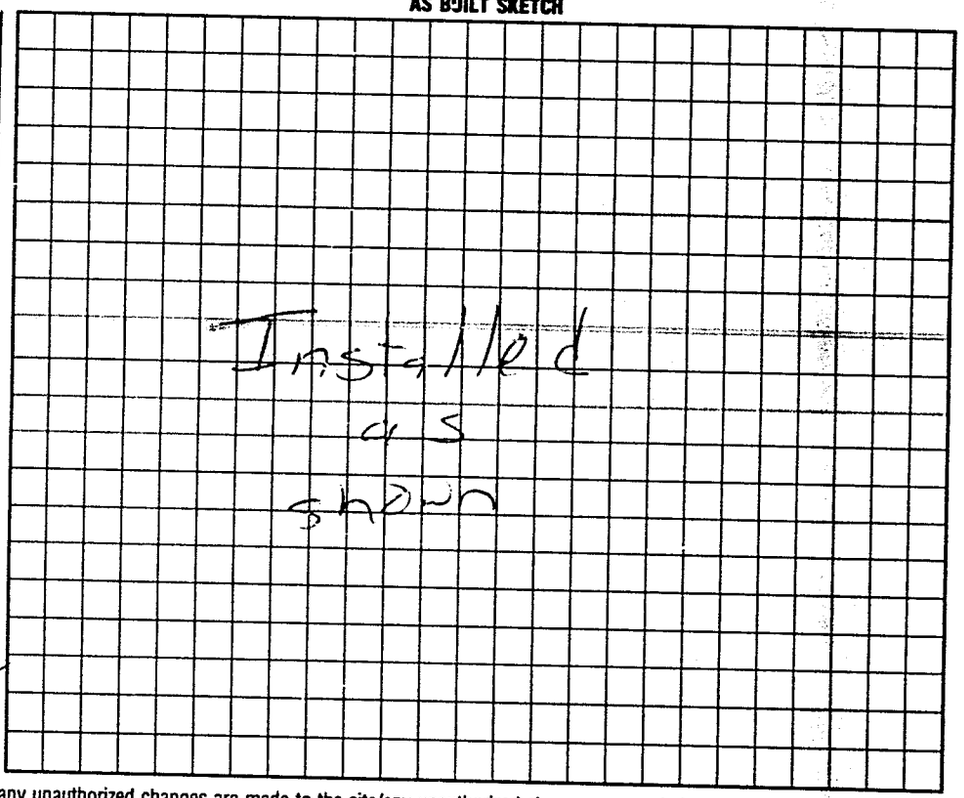

I understand that this permit can be suspended or revoked if any false information is supplied toward securing the permit/any unauthorized changes are made to the site/any unauthorized changes are made in the installation of the system. Improvement Permit is valid for 60 months from date of issuance. Authorization to construct expires 5yrs from issue date

Signed: Terry Jenkins

Improvement Permit by: Mark Cox RS date 7-23-97

Existing System Inspection by: Authorization to Const. Mark Cox RS date 7-23-97

Installed by: Tommy Tyler

Certificate of Completion by: date

Operation Permit by: Mark Cox RS date 2-10-98

HEALTH DEPT. COPY: WHITE INSPECTION COPY (FINAL): GREEN OWNER COPY (FINAL): YELLOW INSPECTION COPY (INITIAL): PINK OWNER COPY (INITIAL): GOLD