# IREDELL COUNTY HEALTH DEPARTMENT

STATESVILLE 704-878-5305 MOORESVILLE 704-664-5281

## IMPROVEMENT PERMIT / AUTHORIZATION TO CONSTRUCT / OPERATION PERMIT / EXISTING SYSTEM INSPECTION

PERMIT# 78683 PIN# 4702299046 DATE 1-9-99

OWNER OR CONTRACTOR Sunwood Builders PHONE: Business 872 0922 Home

ADDRESS PO Box 5877 Statesville

LOCATION Old mtn Rd TR Lewis Ferry Rd Turn Eufola TR Broad meadow 1st rt 3rd lot rt

SUBDIVISION Broad meadows BLOCK / SECTION LOT 12 LOT AREA 1.04 acres SITE CLASS PS DESIGN FLOW 360 L.T.A.R. .3

Septic Tank: 1000 Gallons; STB 1012 Date 1-15-99
Pump Tank: Gallons; PT Date
Pump Make: Model Serial No
Nitrification Field: No Fields 1 Square Feet 1200 Linear Feet 400
No Lines 4 Trench Width 36" Max Trench Bottom Depth 36" Gravel Depth 12"

☒ New System ☐ Repair System Type: I II III IV V VI
System Description: Conv. Conventional
Repair System Description:
Maintenance Agreement Required: ☐ Yes ☒ No

☐ House/Mod. Home ☐ Mobile Home ☐ Business ☐ Other
No. Bedrooms 3 No. Bathrooms 2 No. Employees


☐ Slab ☒ Crawl Space ☐ Basement w/plumbing ☐ Basement wo/plumbing

Water Supply: ☐ Individual ☒ Public ☐ Community


Comments/Conditions:

Comments/Conditions

INITIAL SITE SKETCH

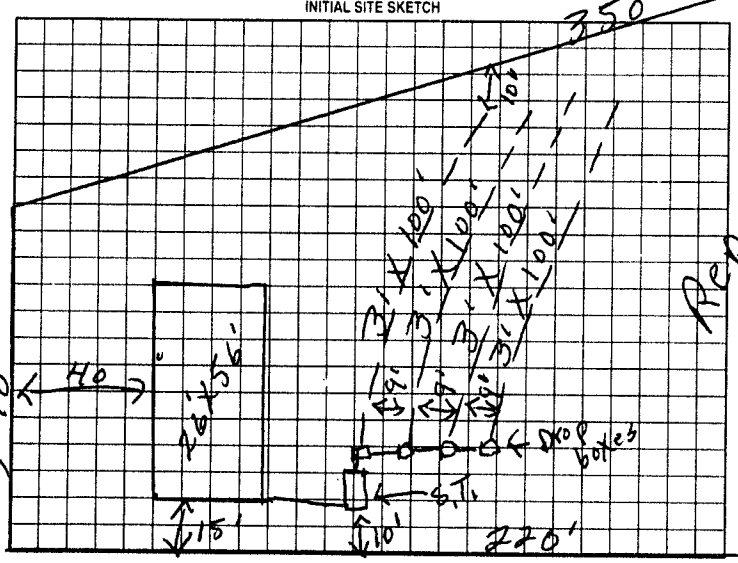


AS BUILT SKETCH

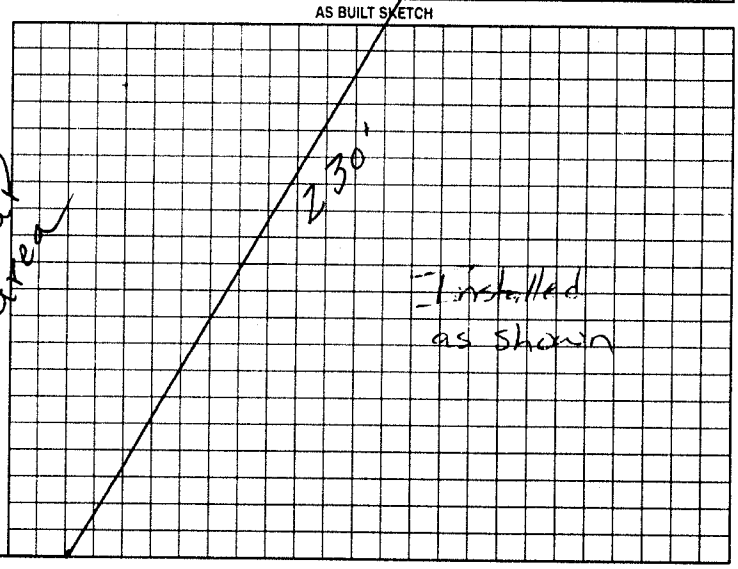


Permit can be suspended or revoked if any false information is supplied toward securing the permit/any unauthorized changes are made to the site/any unauthorized changes are made in the installation of the system. Improvement Permit with plat valid without expiration. Improvement Permit with site plan valid for sixty months. Authorization to Construct is valid for a period equal to that of Improvement Permit – not to exceed sixty months.

Signed: [signature] date 1/19/99 Installed by: Tommy Frye

Improvement Permit by: P.C. Moore date 1-9-99 Operation Permit by: 911st C Ost PS date 3-23-99

Authorization to Construct by: P.C. Moore date 1-9-99 Existing System Inspection by: date

HEALTH DEPT COPY WHITE OWNER COPY (FINAL) YELLOW OWNER COPY (INITIAL) PINK