IREDELL COUNTY HEALTH DEPARTMENT

STATESVILLE 704-878-5305 MOORESVILLE 704-664-5281

IMPROVEMENT PERMIT / AUTHORIZATION TO CONSTRUCT / OPERATION PERMIT / EXISTING SYSTEM INSPECTION

PERMIT# 78685 PIN# 4702299046 DATE 1-9-99

OWNER OR CONTRACTOR Sunwood Builders PHONE: Business 872-0922 Home

ADDRESS PO Box 5877 Statesville N.C.

LOCATION OMA Turn Lewis Ferry TR Eufola TR Broadmeadow Turn 1st Rt 4th lot Rt

SUBDIVISION Broadmeadows BLOCK / SECTION 3 LOT 13 LOT AREA 1.08 acres SITE CLASS. PS DESIGN FLOW 360 L.T.A.R. .3

Septic Tank: 1000 Gallons; STB 1012 Date 3-15-99
Pump Tank: Gallons; PT Date
Pump Make: Model Serial No.
Nitrification Field: No Fields 1 Square Feet 1200 Linear Feet 400
No Lines 4 Trench Width 36" Max Trench Bottom Depth 36" Gravel Depth 12"

☑ New System ☐ Repair System Type: ☐ I, II, IV, V, VI
System Description: Conv. Gravity
Repair System Description:
Maintenance Agreement Required ☐ Yes ☑ No

☐ House/Mod. Home No. Bedrooms 3
☑ Mobile Home No. Bathrooms 2
☐ Business No. Employees
☐ Other


☐ Slab ☑ Crawl Space ☐ Basement w/plumbing ☐ Basement wo/plumbing

Water Supply: ☐ Individual ☑ Public ☐ Community

Comments/Conditions:

Comments /Conditions:

INITIAL SITE SKETCH

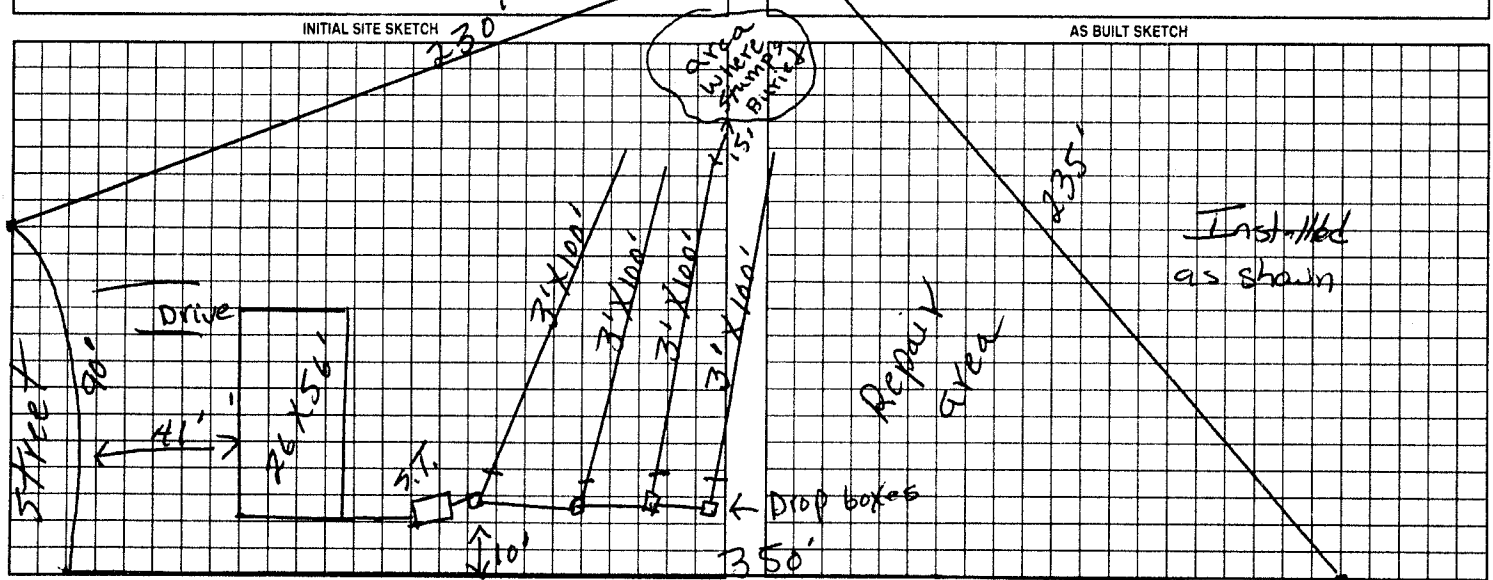

AS BUILT SKETCH

Permit can be suspended or revoked if any false information is supplied toward securing the permit/any unauthorized changes are made to the site/any unauthorized changes are made in the installation of the system. Improvement Permit with plat valid without expiration. Improvement Permit with site plan valid for sixty months. Authorization to Construct is valid for a period equal to that of Improvement Permit – not to exceed sixty months.

Signed: [signature] date 1/19/99 Installed by: Tommy Fry

Improvement Permit by: P. C. Moore date 1-9-99 Operation Permit by: Mary C Coffey RS date 5-10-99

Authorization to Construct by: P. C. Moore date 1-9-99 Existing System Inspection by: date

HEALTH DEPT COPY WHITE OWNER COPY (FINAL) YELLOW OWNER COPY (INITIAL) PINK