IREDELL COUNTY HEALTH DEPARTMENT

STATESVILLE 704-878-5305 MOORESVILLE 704-664-5281

IMPROVEMENT PERMIT / AUTHORIZATION TO CONSTRUCT / OPERATION PERMIT / EXISTING SYSTEM INSPECTION

PERMIT# 78681 PIN# 4702299046 DATE 3-8-99

OWNER OR CONTRACTOR Sunwood Builders PHONE: Business 872 0922 Home

ADDRESS PO Box 5877 Statesville, N.C.

LOCATION OMR Turn Lewis Ferry TR Enfola TR Broadmeadows TR cripplecreek 4th 1st Rt.

SUBDIVISION ~~Broadmeadows~~ BLOCK / SECTION 3 LOT 14 LOT AREA 1.64 acres SITE CLASS PS DESIGN FLOW 360 L.T.A.R. .3

Septic Tank: 1000 Gallons; STB 1012 Date 12-29-98

Pump Tank: Gallons; PT Date

Pump Make: Model Serial No.

Nitrification Field: No Fields 1 Square Feet 900 Linear Feet 300

No Lines 3 Trench Width 36" Max Trench Bottom Depth 36" Gravel Depth 12"

☑ New System ☐ Repair System Type: I, II, III, IV, V, VI

System Description: ~~Conv.~~ 2570 Ref.

Repair System Description: 2570 Ref

Maintenance Agreement Required: ☐ Yes ☑ No

☐ House/Mod. Home ☑ Mobile Home ☐ Business ☐ Other ☐ Slab ☑ Crawl Space ☐ Basement w/plumbing ☐ Basement wo/plumbing


No. Bedrooms 3 No. Bathrooms 2 No. Employees

Water Supply: ☐ Individual ☒ Public ☐ Community


Comments/Conditions: Replace Permit issued 1-9-99

Comments/Conditions:

INITIAL SITE SKETCH

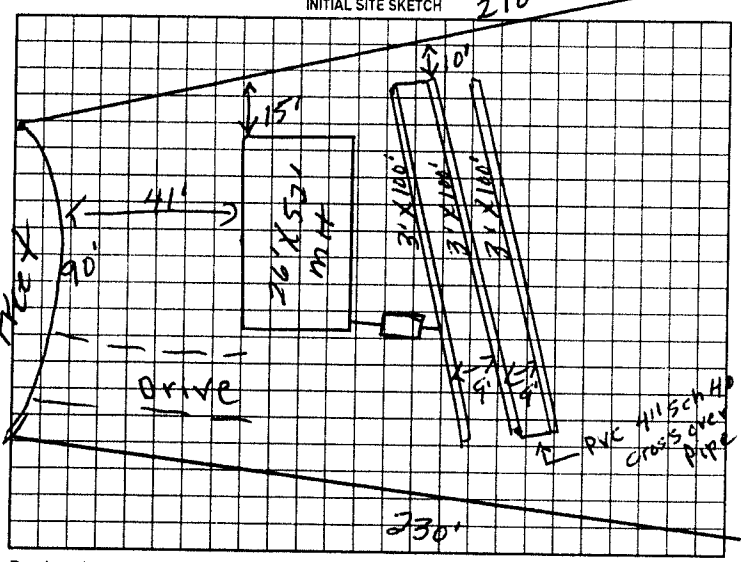

AS BUILT SKETCH

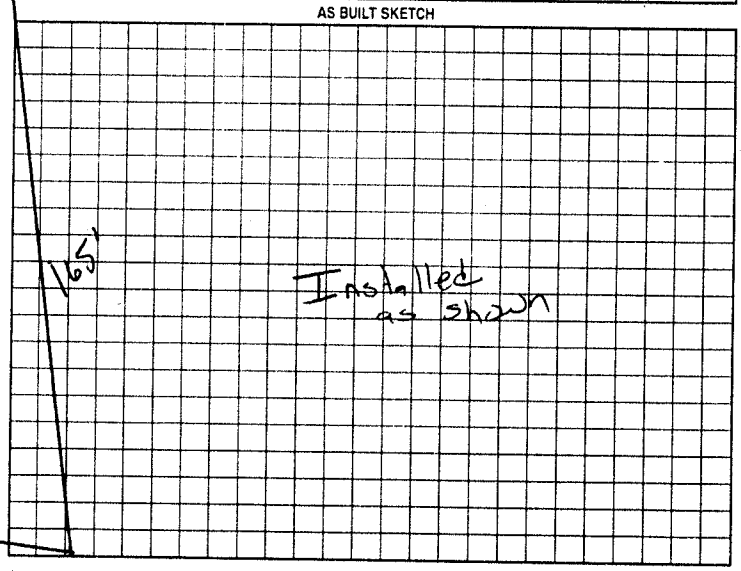

Permit can be suspended or revoked if any false information is supplied toward securing the permit/any unauthorized changes are made to the site/any unauthorized changes are made in the installation of the system. Improvement Permit with plat valid without expiration. Improvement Permit with site plan valid for sixty months. Authorization to Construct is valid for a period equal to that of Improvement Permit – not to exceed sixty months.

Signed: Perry Jenkins date

Improvement Permit by: P.C. Moore date 3-8-99

Authorization to Construct by: P.C. Moore date 3-8-99

Installed by: Tommy Frye

Operation Permit by: Mary C Ott RS date 3-10-99

Existing System Inspection by: date

HEALTH DEPT COPY WHITE OWNER COPY (FINAL) YELLOW OWNER COPY (INITIAL) PINK