# IREDELL COUNTY HEALTH DEPARTMENT

STATESVILLE 704-878-5305 MOORESVILLE 704-664-5281

## IMPROVEMENT PERMIT / CERTIFICATE OF COMPLETION / OPERATION PERMIT / EXISTING SYSTEM INSPECTION

PROPERTY DESCRIPTION NO. 068055 DATE 7-19-97 TAX MAP NO. 4702297046 Watershed: ☐ Yes ☐ No

OWNER OR CONTRACTOR Sun Wood Builders PHONE: Business 704-872-0921 Home WS IV PA

ADDRESS PO Box 5877 Statesville NC

LOCATION ~~Hwy TL Eutsler Rd~~ 70W TL Eutsler Rd on Left Before Lewis Ferry (lot near Fence line)

SUBDIVISION Broad Meadow BLOCK / SECTION ____ LOT 1 LOT AREA 21,780±ft SITE CLASS. P/S DESIGN FLOW 360 L.T.A.R. 0.3

Septic Tank: 1000 Gallons; STB 1012 Date 9-17-97

Pump Tank: ____ Gallons; PT ____ Date ____

Pump Make: ____ Model ____ Serial No. ____

Nitrification Field: No Fields 1 Square Feet 1200 Linear Feet 400

No Lines 5 Trench Width 36in Max Trench Bottom Depth 36in Gravel Depth 12in

☒ New System ☐ Repair System Type: I, II, III, IV, V, VI

System Description: Gravity Conventional

Repair System Description: Pump Conv/Chambers

Maintenance Agreement Required: ☐ Yes ☒ No

☐ House/Mod. Home ☒ Mobile Home ☐ Business ☐ Other

No. Bedrooms 3 No. Bathrooms 2 No. Employees ____


☐ Slab ☒ Crawl Space ☐ Basement w/plumbing ☐ Basement wo/plumbing

Water Supply: ☐ Individual ☐ Community ☒ Public


Comments: Keep lines on contour 9ft on center
Keep water line 10ft from system.

Comments:

INITIAL SITE SKETCH

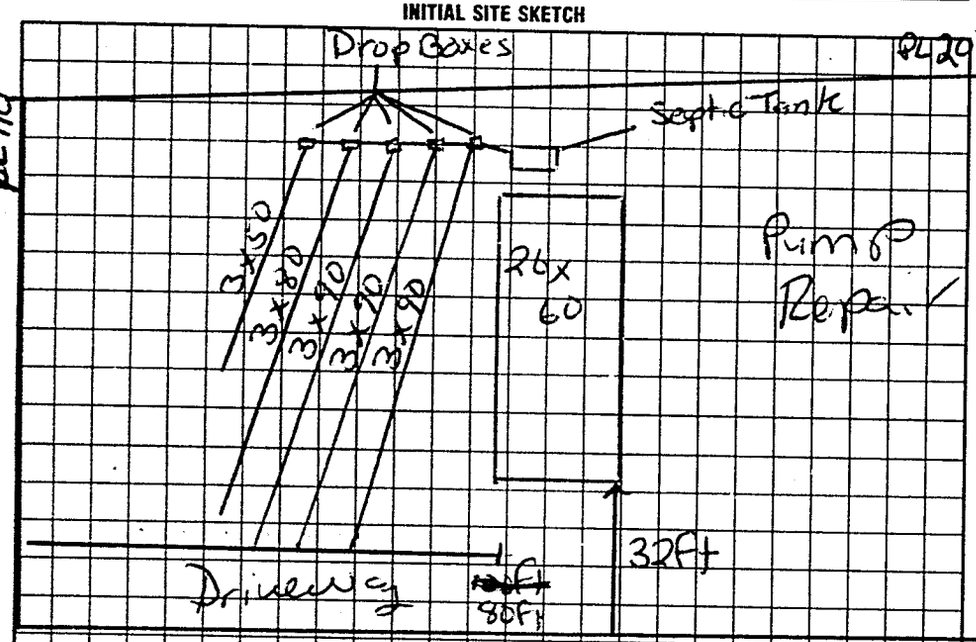


AS BUILT SKETCH

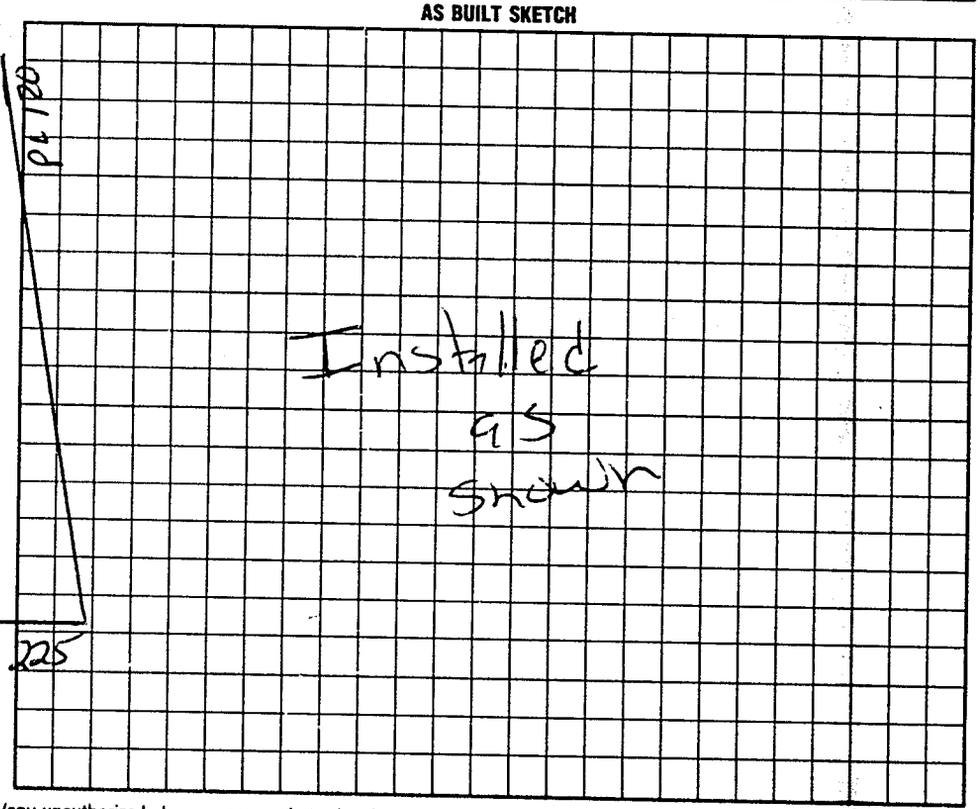


I understand that this permit can be suspended or revoked if any false information is supplied toward securing the permit/any unauthorized changes are made to the site/any unauthorized changes are made in the installation of the system. Improvement Permit is valid for 60 months from date of issuance. Authorization to Construct expires 5yrs from issue date

Signed: Terry W Yokum

Improvement Permit by: Mary C Outlaw date 7-19-97

~~Existing System Inspection by:~~ Authorization to Cont. Mary C Outlaw date 7-19-97

Installed by: Tommy Frye

Certificate of Completion by: ____ date ____

Operation Permit by: Mary C Outlaw date 1-21-98

HEALTH DEPT COPY: WHITE INSPECTION COPY (FINAL): GREEN OWNER COPY (FINAL): YELLOW INSPECTION COPY (INITIAL): PINK OWNER COPY (INITIAL): GOLD