IREDELL COUNTY HEALTH DEPARTMENT

CI

STATESVILLE 704-878-5305 MOORESVILLE 704-664-5281

IMPROVEMENT PERMIT / AUTHORIZATION TO CONSTRUCT / OPERATION PERMIT / EXISTING SYSTEM INSPECTION

PERMIT# 13782 PIN# 4702396093 DATE 8-30-06

OWNER OR APPLICANT JENKINS & WILLIAMS (ast Co PHONE: Business 704-872-0921/0922 Home

ADDRESS PO BOX 5877 Statesville NC 28687

LOCATION BUFFALO SHOALS (R) EUFOLA (R) BROAD MEADOW (R) Cripple Creek property on cul-de-sad

SUBDIVISION BROAD MEADOWS BLOCK / SECTION III LOT 18 LOT AREA 1.262 AC SITE CLASS. PS DESIGN FLOW 360 L.T.A.R. .3

Septic Tank: 1000 Gallons; STB 1007 Date 7-1-06
Pump Tank: Gallons; PT Date
Pump Make: Model Serial No.
Nitrification Field: No Fields 1 Square Feet EP=1200 Linear Feet 300'
No Lines 4X75' Trench Width 36" Max Trench Bottom Depth 36"

☒ New System ☐ Repair ☐ Expansion System Type: I (II) III IV V VI
System Description: GRAVITY 25%
Repair System Description: LP 25%
Maintenance Agreement Required: ☐ Yes ☒ No

☐ House/Mod. Home No. Bedrooms 3
☒ Mobile Home D/W No. Persons 6
☐ Business No. Employees
☐ Other

Water Supply: ☐ Individual ☒ Public ☐ Community


Gravel Depth ☒ Gravity ☐ Pressure ☐ Slab ☒ Crawl Space ☐ Basement w/plumbing ☐ Basement wo/plumbing

Comments:/Conditions: (1) INSTALL LINES ON CONTOURS (2) SYSTEM MAY CHANGE DUE TO LOT NOT BEING CLEARED; CALL IF CHANGES ARE MADE BY INSTALLING, FOR APPROVAL;


Comments:/Conditions: (3) MAINTAIN SETBACKS

BOWED Filter Compartment; 40' FROM HOUSE TO TANK

INITIAL SITE SKETCH

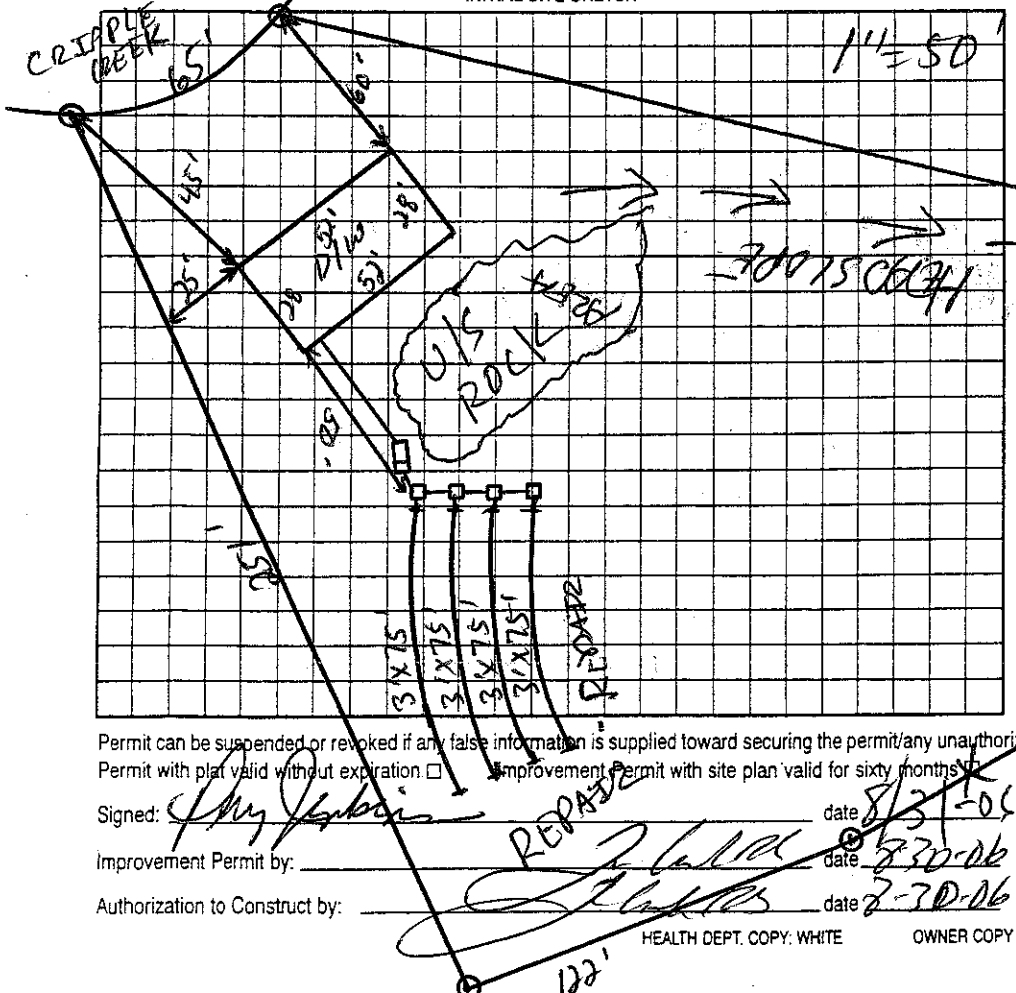

AS BUILT SKETCH

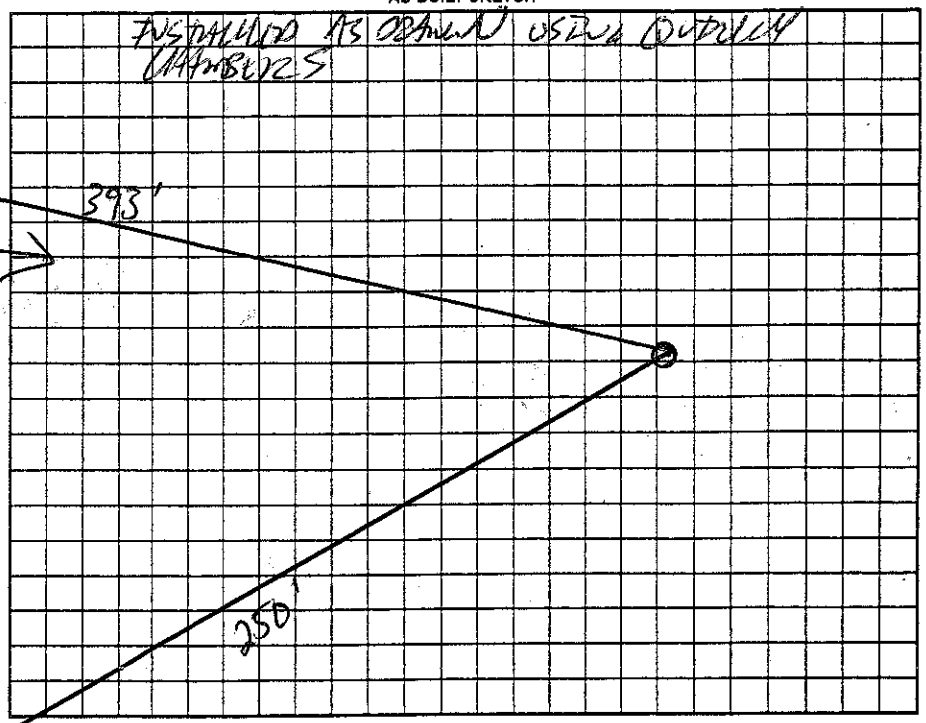

Permit can be suspended or revoked if any false information is supplied toward securing the permit/any unauthorized changes are made to the site/any unauthorized changes are made in the installation of the system. Improvement Permit with plat valid without expiration ☐ Improvement Permit with site plan valid for sixty months ☒ Authorization to Construct is valid for a period equal to that of Improvement Permit – not to exceed sixty months.

Signed: date 8-31-06

REPAIR

Improvement Permit by: date 8-30-06

Authorization to Construct by: date 8-30-06

Installed by: Tommy Cotton

Operation Permit by: date 10-16-06

Existing System Inspection by: date

HEALTH DEPT. COPY: WHITE OWNER COPY (FINAL): YELLOW OWNER COPY (INITIAL): PINK