# IREDELL COUNTY HEALTH DEPARTMENT

STATESVILLE 704-878-5305 MOORESVILLE 704-664-5281

## IMPROVEMENT PERMIT / AUTHORIZATION TO CONSTRUCT / OPERATION PERMIT / EXISTING SYSTEM INSPECTION

PERMIT# 91497 PIN# 4702 53 ~~2993~~ 3994

OWNER OR CONTRACTOR Darrel Oliver DATE 8-29-00

ADDRESS 146 Wingtrelm LN Mooresville, N.C. PHONE: Business 6637520 Home

LOCATION off mtn Rd Turn Lewis Ferry cross Eufola Then TR Long Island 1/4 mi on left

SUBDIVISION BLOCK / SECTION LOT LOT AREA 22.21 acres SITE CLASS. PS DESIGN FLOW 360 L.T.A.R. .3

Septic Tank: 1000 Gallons; STB 825 Date SIT 30 DAYS

Pump Tank: Gallons; PT Date

Pump Make: Model Serial No.

Nitrification Field: No Fields 1 Square Feet 1200 Linear Feet 400

No Lines 3 Trench Width 36" Max Trench Bottom Depth 36" Gravel Depth 12"

☑ New System ☐ Repair System Type: I, II, III, IV, V, VI

System Description: Conv. Gravity

Repair System Description: " "

Maintenance Agreement Required: ☐ Yes ☑ No

☐ House/Mod. Home No. Bedrooms 3

☑ Mobile Home No. Bathrooms 2

☐ Business No. Employees

☐ Other


☐ Slab ☑ Crawl Space ☐ Basement w/plumbing ☐ Basement wo/plumbing

Water Supply: ☑ Individual ☐ Public ☐ Community


Comments:/Conditions:

Comments:/Conditions: POLYLOK FILTER + MARKER, INSTALLED AS DRAWN WITH DISTRIBUTION BOX + SPEED LEVELERS

INITIAL SITE SKETCH

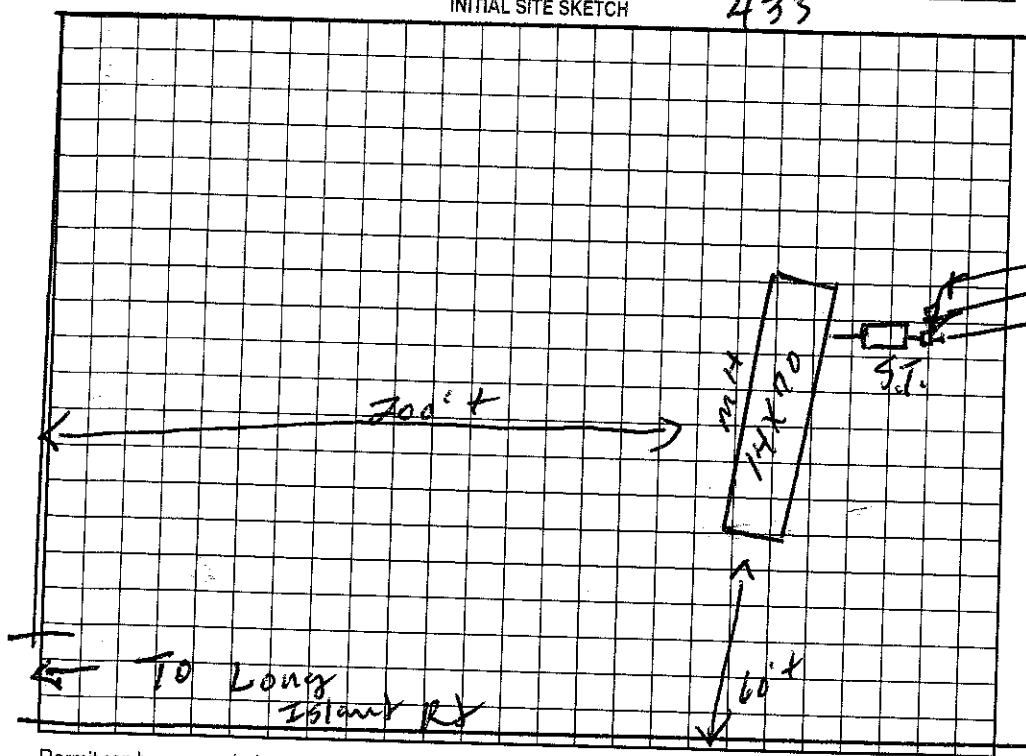


AS BUILT SKETCH

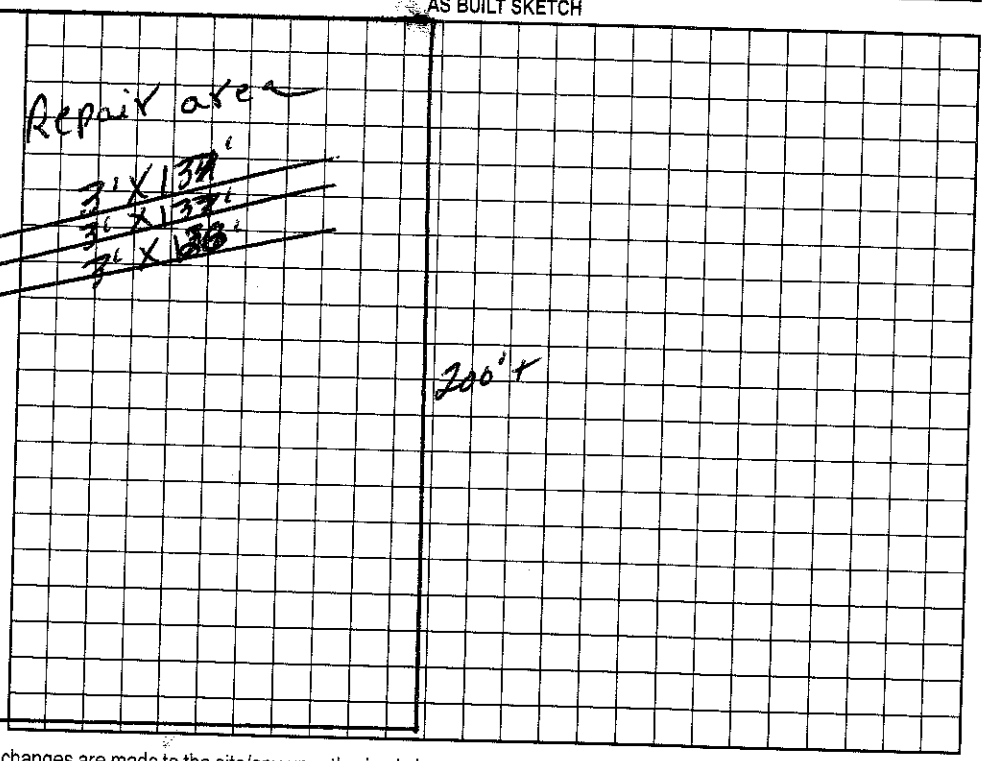


Permit can be suspended or revoked if any false information is supplied toward securing the permit/any unauthorized changes are made to the site/any unauthorized changes are made in the installation of the system. Improvement Permit with plat valid without expiration. Improvement Permit with site plan valid for sixty months. Authorization to Construct is valid for a period equal to that of Improvement Permit – not to exceed sixty months.

Signed: David Z. Adams date Installed by: GERALD TUCKER SEPTIC

Improvement Permit by: J. C. Moore date 8-29-00 Operation Permit by: Jim Cash RS date 8-12-03

Authorization to Construct by: J. C. Moore date 8-29-00 Existing System Inspection by: date

HEALTH DEPT. COPY: WHITE OWNER COPY (FINAL): YELLOW OWNER COPY (INITIAL): PINK