IREDELL COUNTY HEALTH DEPARTMENT

Fred on Comp.

STATESVILLE 704-878-5305 MOORESVILLE 704-664-5281

55099

IMPROVEMENT PERMIT / CERTIFICATE OF COMPLETION / OPERATION PERMIT / EXISTING SYSTEM INSPECTION

PROPERTY DESCRIPTION NO. 20518 DATE 3-22-95 TAX MAP NO. Pt. of 8C-A-5 Watershed: ☐ Yes ☑ No

OWNER OR CONTRACTOR Thomas Tatum PHONE: Business _____ Home 872-0319

ADDRESS 750 Lewis Ferry Rd. Statesville, N.C. 28677

LOCATION I40W TL Old Mtn. Rd TR Lewis Ferry Rd house behind 2nd house on R after crossing Eufola Rd.

SUBDIVISION NA BLOCK / SECTION — LOT — LOT AREA 2 acres SITE CLASS. P.S. DESIGN FLOW 240 L.T.A.R. .3 gpd/ft²

Septic Tank: 1000 Gallons; STB 760 Date 3-24-95

Pump Tank: — Gallons; PT — Date —

Pump Make: — Model — Serial No. —

Nitrification Field: No Fields 1 Square Feet 800 Linear Feet 266'

No Lines 3 Trench Width 36" Max Trench Bottom Depth 24" Gravel Depth 12"

☑ New System ☐ Repair System Type: I, II, III, IV, V, VI

System Description: conventional/gravity fed.

Repair System Description: pump to conventional

Maintenance Agreement Required: ☐ Yes ☑ No

☑ House/Mod. Home No. Bedrooms 2

☐ Mobile Home No. Bathrooms 1.5

☐ Business No. Employees ____

☐ Other ____


☐ Slab ☑ Crawl Space ☐ Basement w/plumbing ☐ Basement wo/plumbing

Water Supply: ☑ Individual ☐ Community ☐ Public


Comments: Install system shallow (no deeper than 24" to trench bottom) Keep lines and trenches on contour. Keep system 5' from foundation of home, 10' from all property lines, and 100' from any well. 100% Repair above system pump to conventional.

Comments: Home located further up hill and further to right then permitted system not located completely in area where permitted. System should have been closer to property lines at end of lines. some rock hit at start of lines but was surrounded by soil. Fed last two lines equal due to 2nd line not being able to back up.

INITIAL SITE SKETCH Maybe able to reroute plumbing, set new tank and get gravity fed Repair.

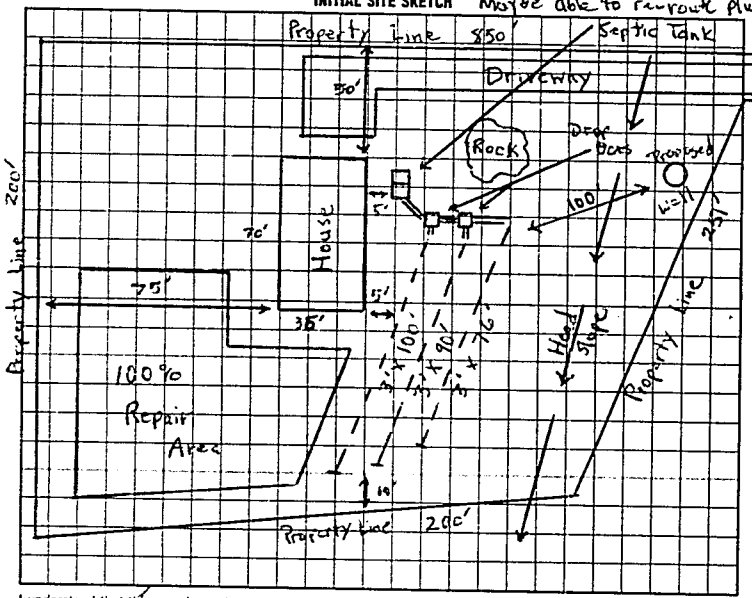

AS BUILT SKETCH

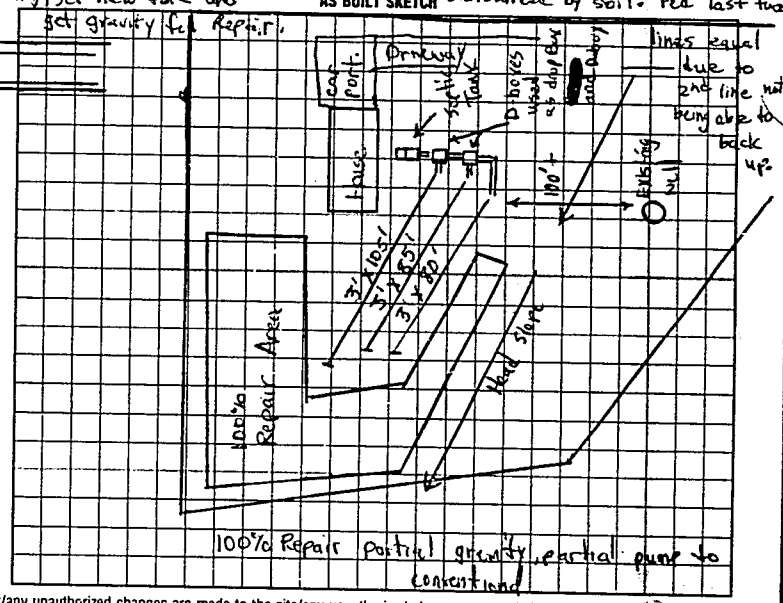

I understand that this permit can be suspended or revoked if any false information is supplied toward securing the permit/any unauthorized changes are made to the site/any unauthorized changes are made in the installation of the system. Improvement Permit is valid for 60 months from date of issuance.

Signed: Thomas Tatum

Improvement Permit by: Michael J. Dimmo date 3-22-95

Existing System Inspection by: _____ date _____

Installed by: Larry Powell

Certificate of Completion by: Michael J. Dimmo date 5-24-95

Operation Permit by: _____ date _____

HEALTH DEPT. COPY: WHITE INSPECTION COPY (FINAL): GREEN OWNER COPY (FINAL): YELLOW INSPECTION COPY (INITIAL): PINK OWNER COPY (INITIAL): GOLD

00244