IREDELL COUNTY HEALTH DEPARTMENT

STATESVILLE 704-878-5305 MOORESVILLE 704-664-5281

IMPROVEMENT PERMIT / AUTHORIZATION TO CONSTRUCT / OPERATION PERMIT / EXISTING SYSTEM INSPECTION

PERMIT# 84434 PIN# 4702479280 DATE Nov 1-99

OWNER OR CONTRACTOR Joey Hall PHONE: Business Home 872 6715

ADDRESS Po Box 5477 Statesville

LOCATION Shoal Mt Rd (R) Ellis Ferry To end (R) Evelda Lt Left Angela Lane Behind 3 M.H. on Left

SUBDIVISION BLOCK / SECTION LOT LOT AREA 1.33 SITE CLASS PS DESIGN FLOW 360 L.T.A.R. .3

Septic Tank: 1000 Gallons; STB 794 Date 12 7 99

Pump Tank: Gallons; PT Date

Pump Make: Model Serial No.

Nitrification Field: No Fields 1 Square Feet 1200 Linear Feet 400

No Lines 4@100 Trench Width 36" Max Trench Bottom Depth 36" Gravel Depth 12"

☐ New System ☐ Repair System Type: I II III IV V VI

System Description: Conv Gravity Gravity Panel Block

Repair System Description: Gravity Panel Block

Maintenance Agreement Required: ☐ Yes ☒ No

☒ House/Mod. Home ☐ Mobile Home ☐ Business ☐ Other

No. Bedrooms 3 No. Bathrooms 2 No. Employees

☐ Slab ☐ Crawl Space ☒ Basement w/plumbing ☐ Basement wo/plumbing


Water Supply: ☒ Individual ☐ Public ☐ Community Well

Comments/Conditions: Keep 100ft from well
4 Drop Boxes, Slope To Drain


PL

Comments/Conditions

INITIAL SITE SKETCH

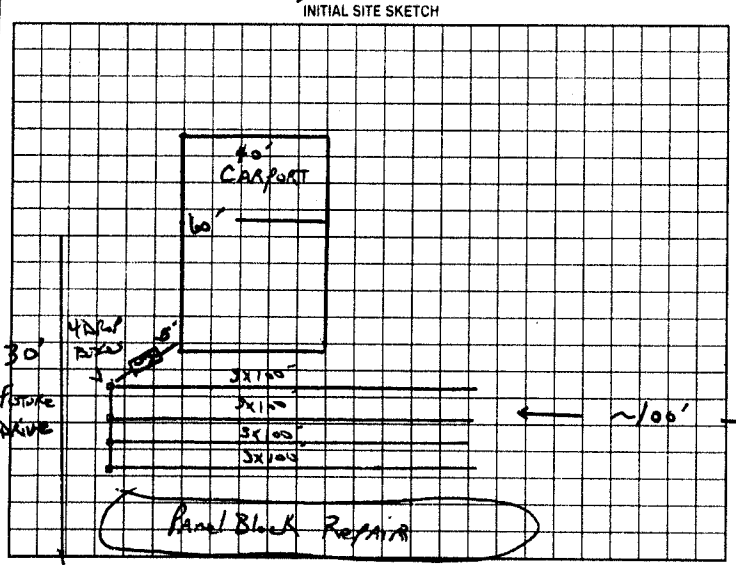

AS BUILT SKETCH

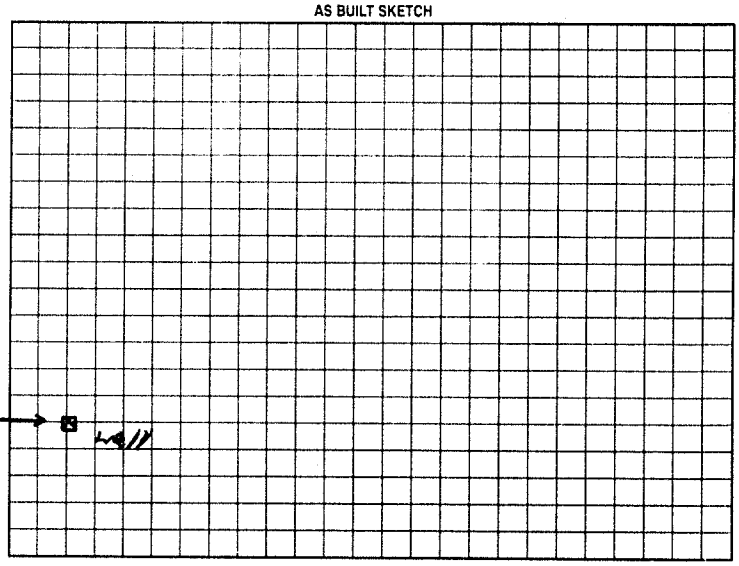

Permit can be suspended or revoked if any false information is supplied toward securing the permit/any unauthorized changes are made to the site/any unauthorized changes are made in the installation of the system. Improvement Permit with plat valid without expiration. Improvement Permit with site plan valid for sixty months. Authorization to Construct is valid for a period equal to that of Improvement Permit – not to exceed sixty months.

Signed: Joey Hall date

Improvement Permit by: J C Potter date Nov 1 99

Authorization to Construct by: J C Potter date Nov 1, 99

Installed by: Dale Winglee

Operation Permit by: J C Potter date Feb 9 2000

Existing System Inspection by: date

HEALTH DEPT. COPY: WHITE OWNER COPY (FINAL): YELLOW OWNER COPY (INITIAL): PINK