IREDELL COUNTY HEALTH DEPARTMENT

Statesville Phone TR 3-7271 Mooresville Phone NO 3-1271

PERMIT TO INSTALL SEPTIC TANK

Permit NO._____ Permit Date 9-24-59 195__

Owner Fox - Clint miller plbr Address Eufla

Installed By CLYDE HOKE Address

RT. 7 BOX 212 STATESVILLE, N.C.

Location of Property Left at Whitesock toward Clint - 1st paved

to R - go thru X Rds. to for left corner


Tank		Capacity		Length of Lines		Fixtures	
Block	( )	800	(X)	150'	(X)	No. of Baths	(X)
Precast	(X)	900	( )	175'	( )	Dishwasher	( )
		1000	( )	200'	( )	Garbage Grdr.	( )
		1100	( )	225'	( )	Auto-Washer	( )
		1200	( )	250'	( )	Other	
		Other		Other			

NOTIFY HEALTH DEPARTMENT AT LEAST EIGHT HOURS BEFORE TANK IS TO BE INSPECTED.

Final Inspection 9 24 59 195__ Approved ( ) Disapproved ( )

Remarks Not for worken - checked by thomas Wells

60'

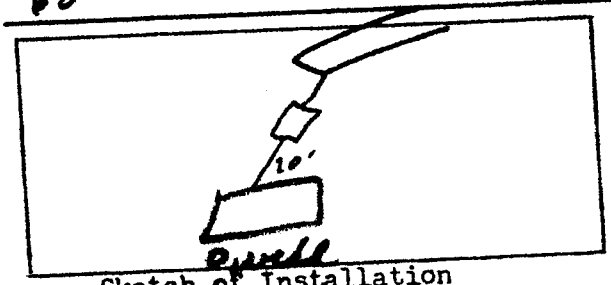

Sketch of Installation

Sanitarian