IREDELL COUNTY HEALTH DEPARTMENT

STATESVILLE 704-878-5305 MOORESVILLE 704-664-5281

IMPROVEMENT PERMIT / AUTHORIZATION TO CONSTRUCT / OPERATION PERMIT / EXISTING SYSTEM INSPECTION

PERMIT# 84392 PIN# 4702587156

OWNER OR CONTRACTOR Silver Wave Prop. PHONE: Business 532 6626 Home

ADDRESS 5551 Monroe Charlotte NC DATE Nov 2 99

LOCATION N old MT Rd (R) Elewis Ferry Lot on Left Before Eufola Rd

SUBDIVISION Rabfield BLOCK / SECTION LOT 47 LOT AREA SITE CLASS I5 DESIGN FLOW 360 L.T.A.R. .3

Septic Tank: 1000 Gallons: STB Date

Pump Tank: Gallons: PT Date

Pump Make: Model Serial No

Nitrification Field: No Fields 1 Square Feet 1200 Linear Feet 300

No Lines 3 Trench Width 36" Max Trench Bottom Depth 36"

☒ New System ☐ Repair System Type: I, II, III, IV, V, VI

System Description: Gravity 25% Reduction

Repair System Description: Same pump possible

Maintenance Agreement Required: ☐ Yes ☒ No

Gravel Depth NA ☐ Slab ☒ Crawl Space ☐ Basement w/plumbing ☐ Basement wo/plumbing

☐ House/Mod. Home ☒ Mobile Home ☐ Business ☐ Other


No. Bedrooms 3 No. Bathrooms 2 No. Employees

Water Supply: ☐ Individual ☒ Public ☐ Community


Comments/Conditions: INSTALL on CONTOUR
30 H&S Sections OR 50 Chambers OR similAR

Comments/Conditions: H&S Section

INITIAL SITE SKETCH

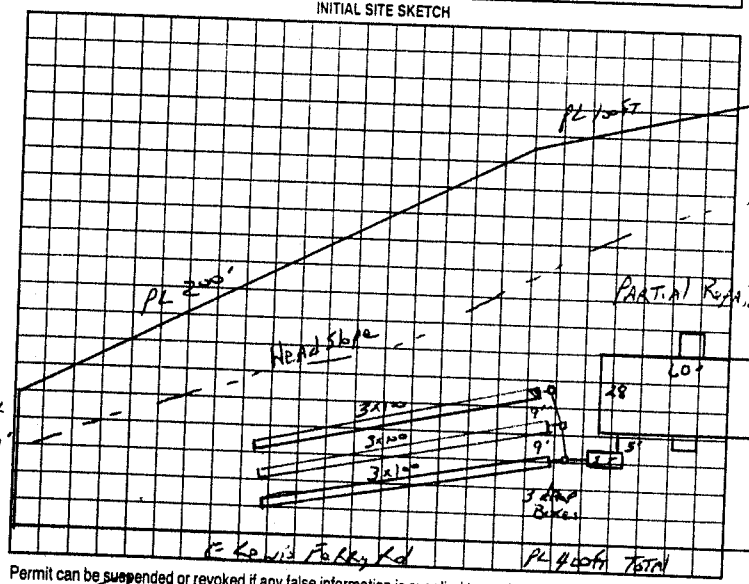

AS BUILT SKETCH

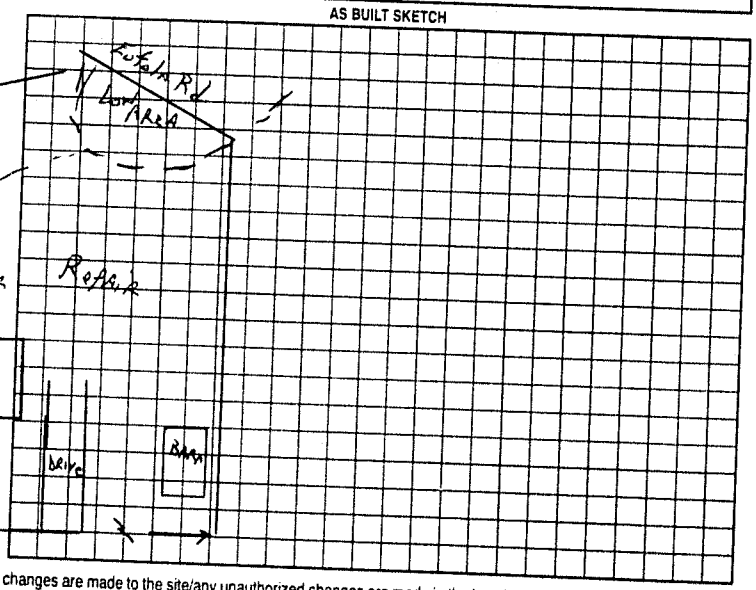

Permit can be suspended or revoked if any false information is supplied toward securing the permit/any unauthorized changes are made to the site/any unauthorized changes are made in the installation of the system. Improvement Permit with plat valid without expiration. Improvement Permit with site plan valid for sixty months. Authorization to Construct is valid for a period equal to that of Improvement Permit – not to exceed sixty months.

Signed: date

Improvement Permit by: L. Potter date Nov 2 99

Authorization to Construct by: L. Potter date Nov 2, 99

Installed by: N/A

Operation Permit by: L. Potter date 5-11-00

Existing System Inspection by: date

HEALTH DEPT. COPY: WHITE OWNER COPY (FINAL): YELLOW OWNER COPY (INITIAL): PINK